
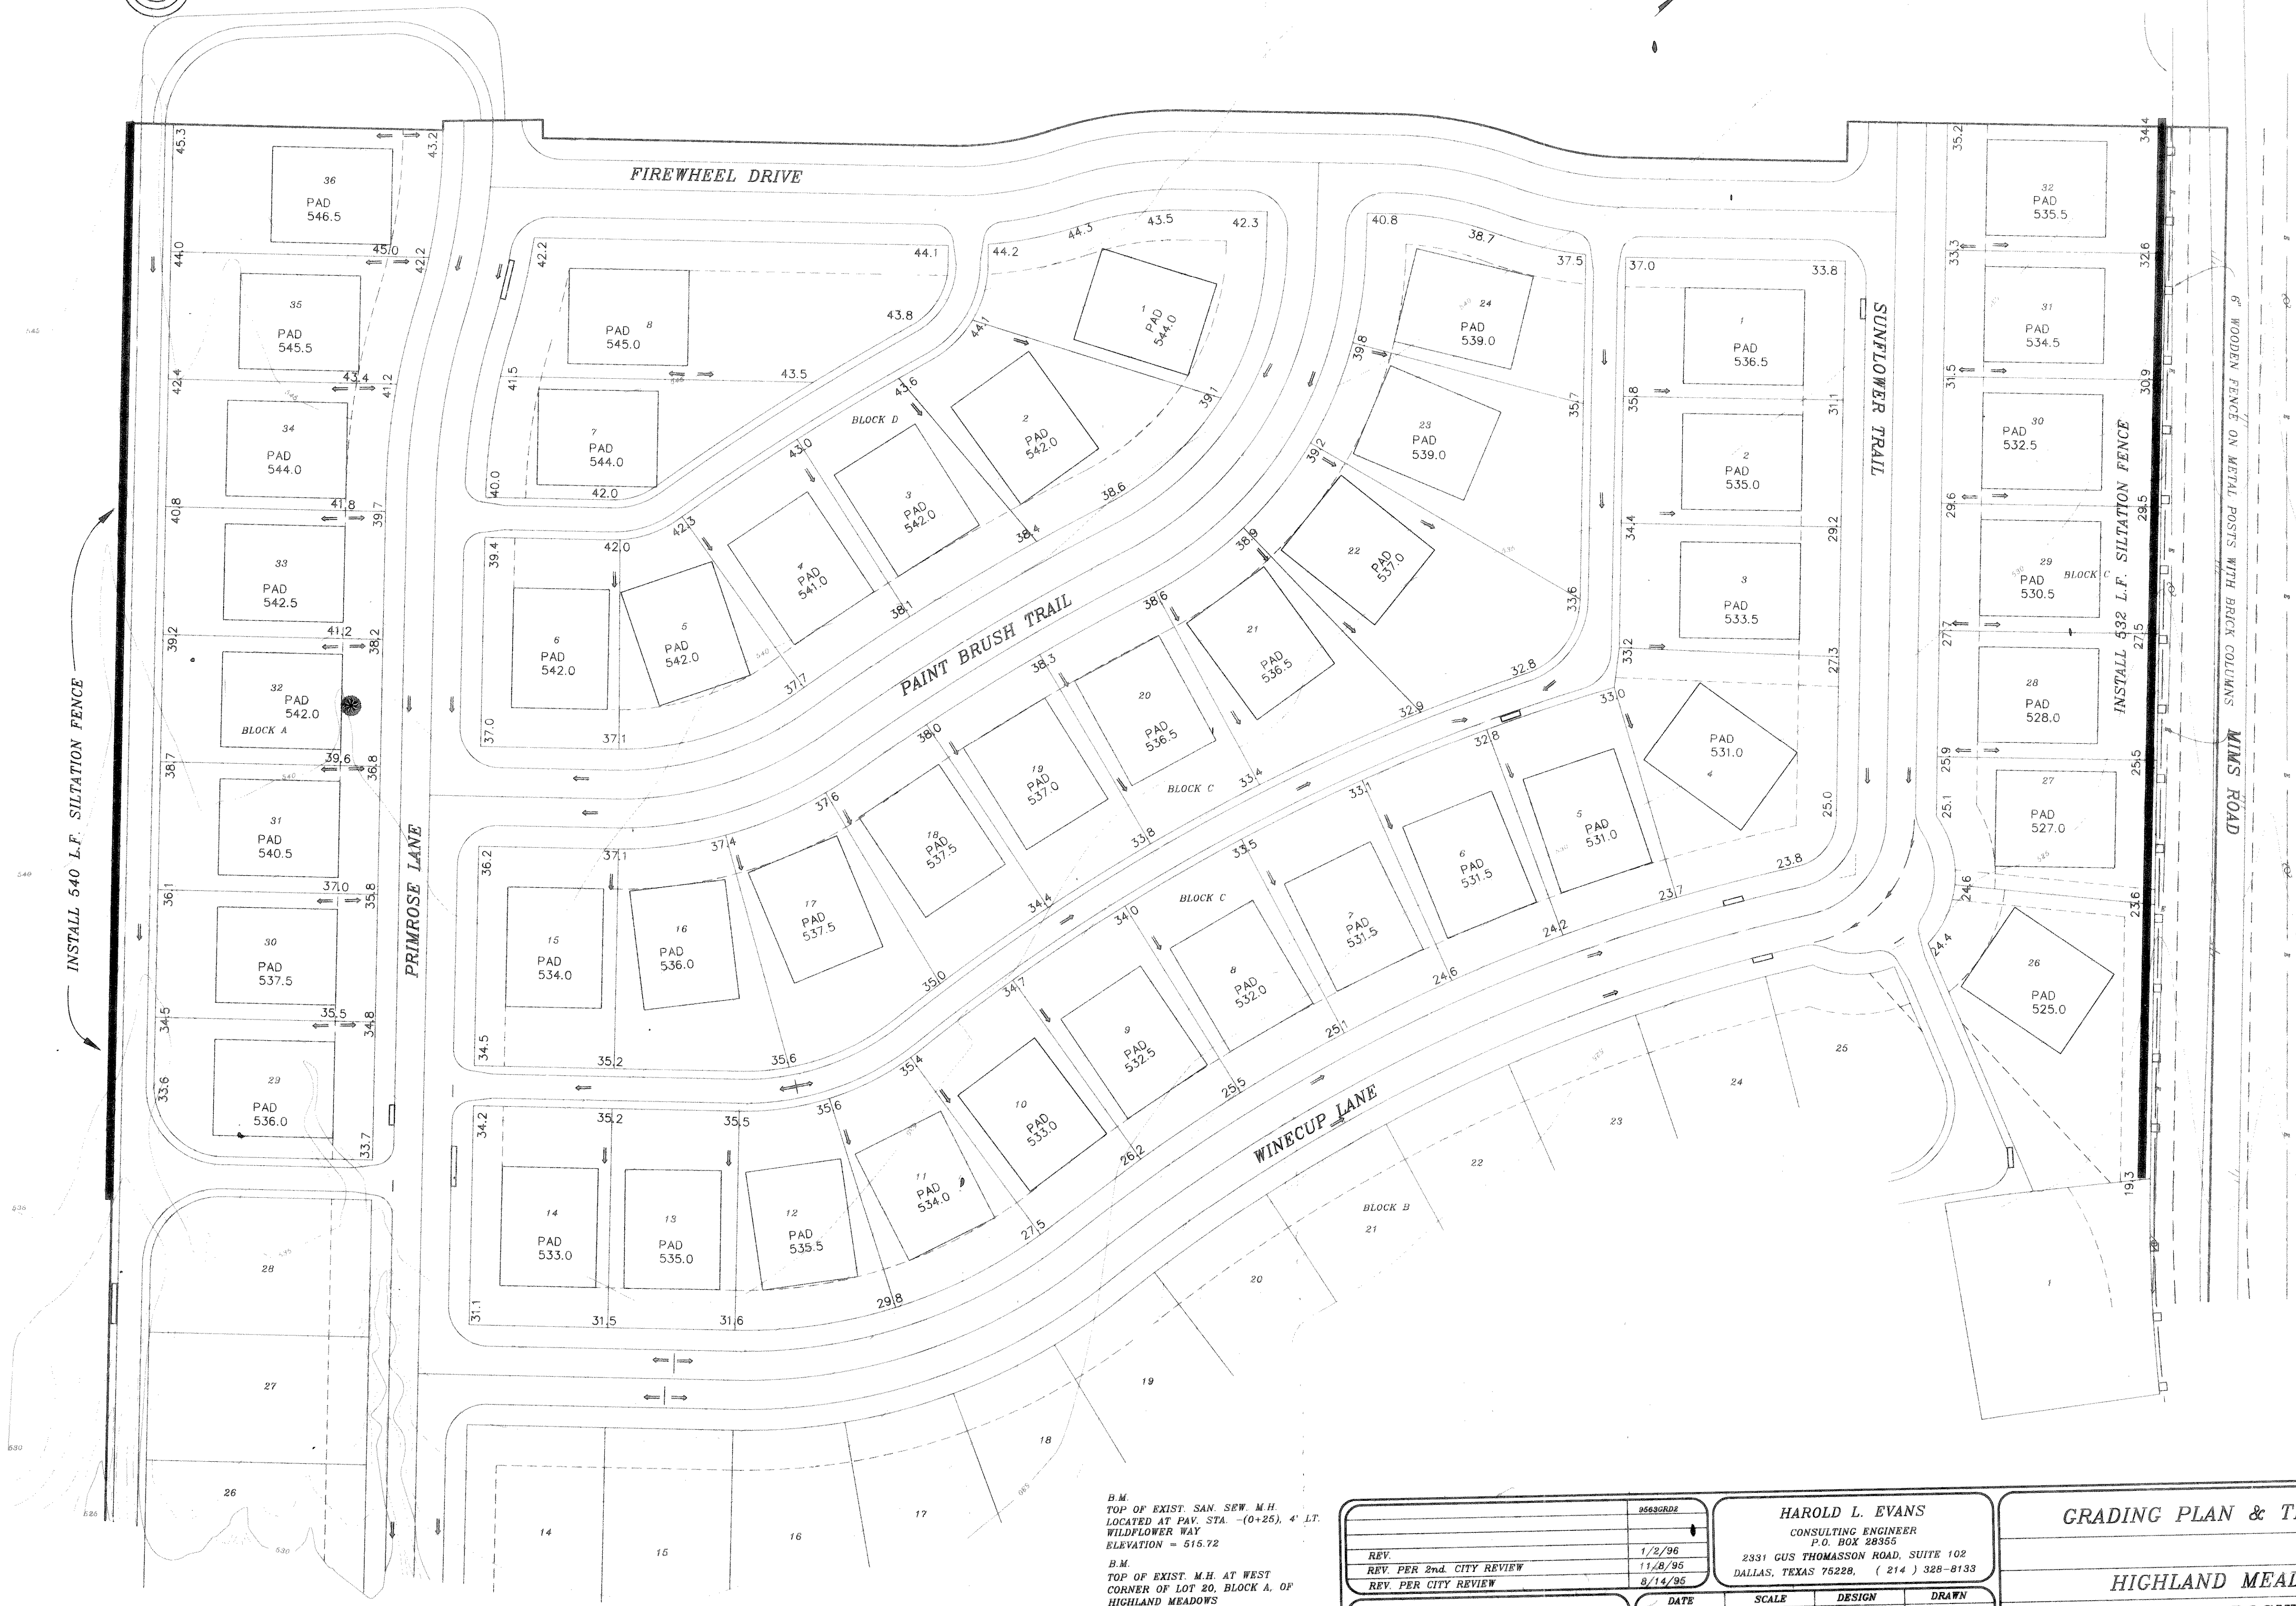


Y INLET
TOP 544.00
THROAT 542.92

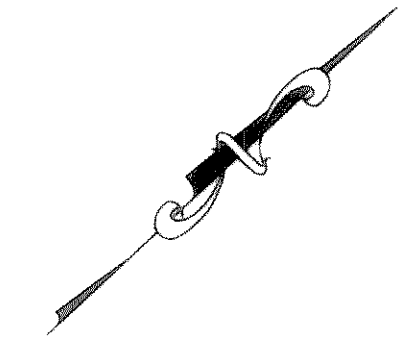

INSTALL 540 L.F. SILTATION FENCE

PRIMROSE LANE

FIREWHEEL DRIVE

PAINT BRUSH TRAIL

WINECUP LANE

SUNFLOWER TRAIL

INSTALL 532 L.F. SILTATION FENCE

6" WOODEN FENCE ON METAL POSTS WITH BRICK COLUMNS
MINS ROAD

B.M.
TOP OF EXIST. SAN. SEW. M.H.
LOCATED AT PAY. STA. (0+25), 4' LT.
WILDFLOWER WAY
ELEVATION = 515.72

B.M.
TOP OF EXIST. M.H. AT WEST
CORNER OF LOT 20, BLOCK A, OF
HIGHLAND MEADOWS
ELEVATION = 514.85

REVISION DESCRIPTION	DATE
REV. PER 2nd CITY REVIEW	1/2/96
REV. PER CITY REVIEW	11/28/95
REV. PER CITY REVIEW	9/14/95
7/16/95	

HAROLD L. EVANS
CONSULTING ENGINEER
P.O. BOX 28355
2331 GUS THOMASSON ROAD, SUITE 102
DALLAS, TEXAS 75228. (214) 328-8133

GRADING PLAN & TREE PLAN

HIGHLAND MEADOWS
CITY OF ROCKWALL



Harold L. Evans
1-86

SHEET NO.
23

JOB NO.
9663