


B.M. LOCATED AT PAV. STA. - (0+25), 4' LT. W/FLORNER WAY
 ELEVATION = 515.22
 B.M. TOP OF EXIST. SAN. SEW. M.H. HIGHLAND MEADOWS
 CORNER OF LOT 20, BLOCK A. OF ELEVATION = 614.85



CURVE	RADIUS	LENGTH	TANGENT	CHORD	BEARING	DELTA
C1	275.00'	191.92'	188.05'	124.128'	89.59209°	39.2215°
C2	874.21'	402.96'	388.82'	517.2558'	26.2215°	78.3257°
C3	50.00'	68.00'	38.45'	61.94'	N07.39.23 W	78.3257°
C4	39.50'	12.90'	24.52'	N46.58.05 E	36.09.34°	12.90°
C5	39.50'	45.52'	25.66'	43.04'	N46.37.13 W	66.01.24°
C6	20.00'	12.15'	6.27'	11.37'	S47.39.30 W	34.48.45°
C7	20.00'	11.77'	6.06'	11.60'	S62.46.47 E	33.42.17°

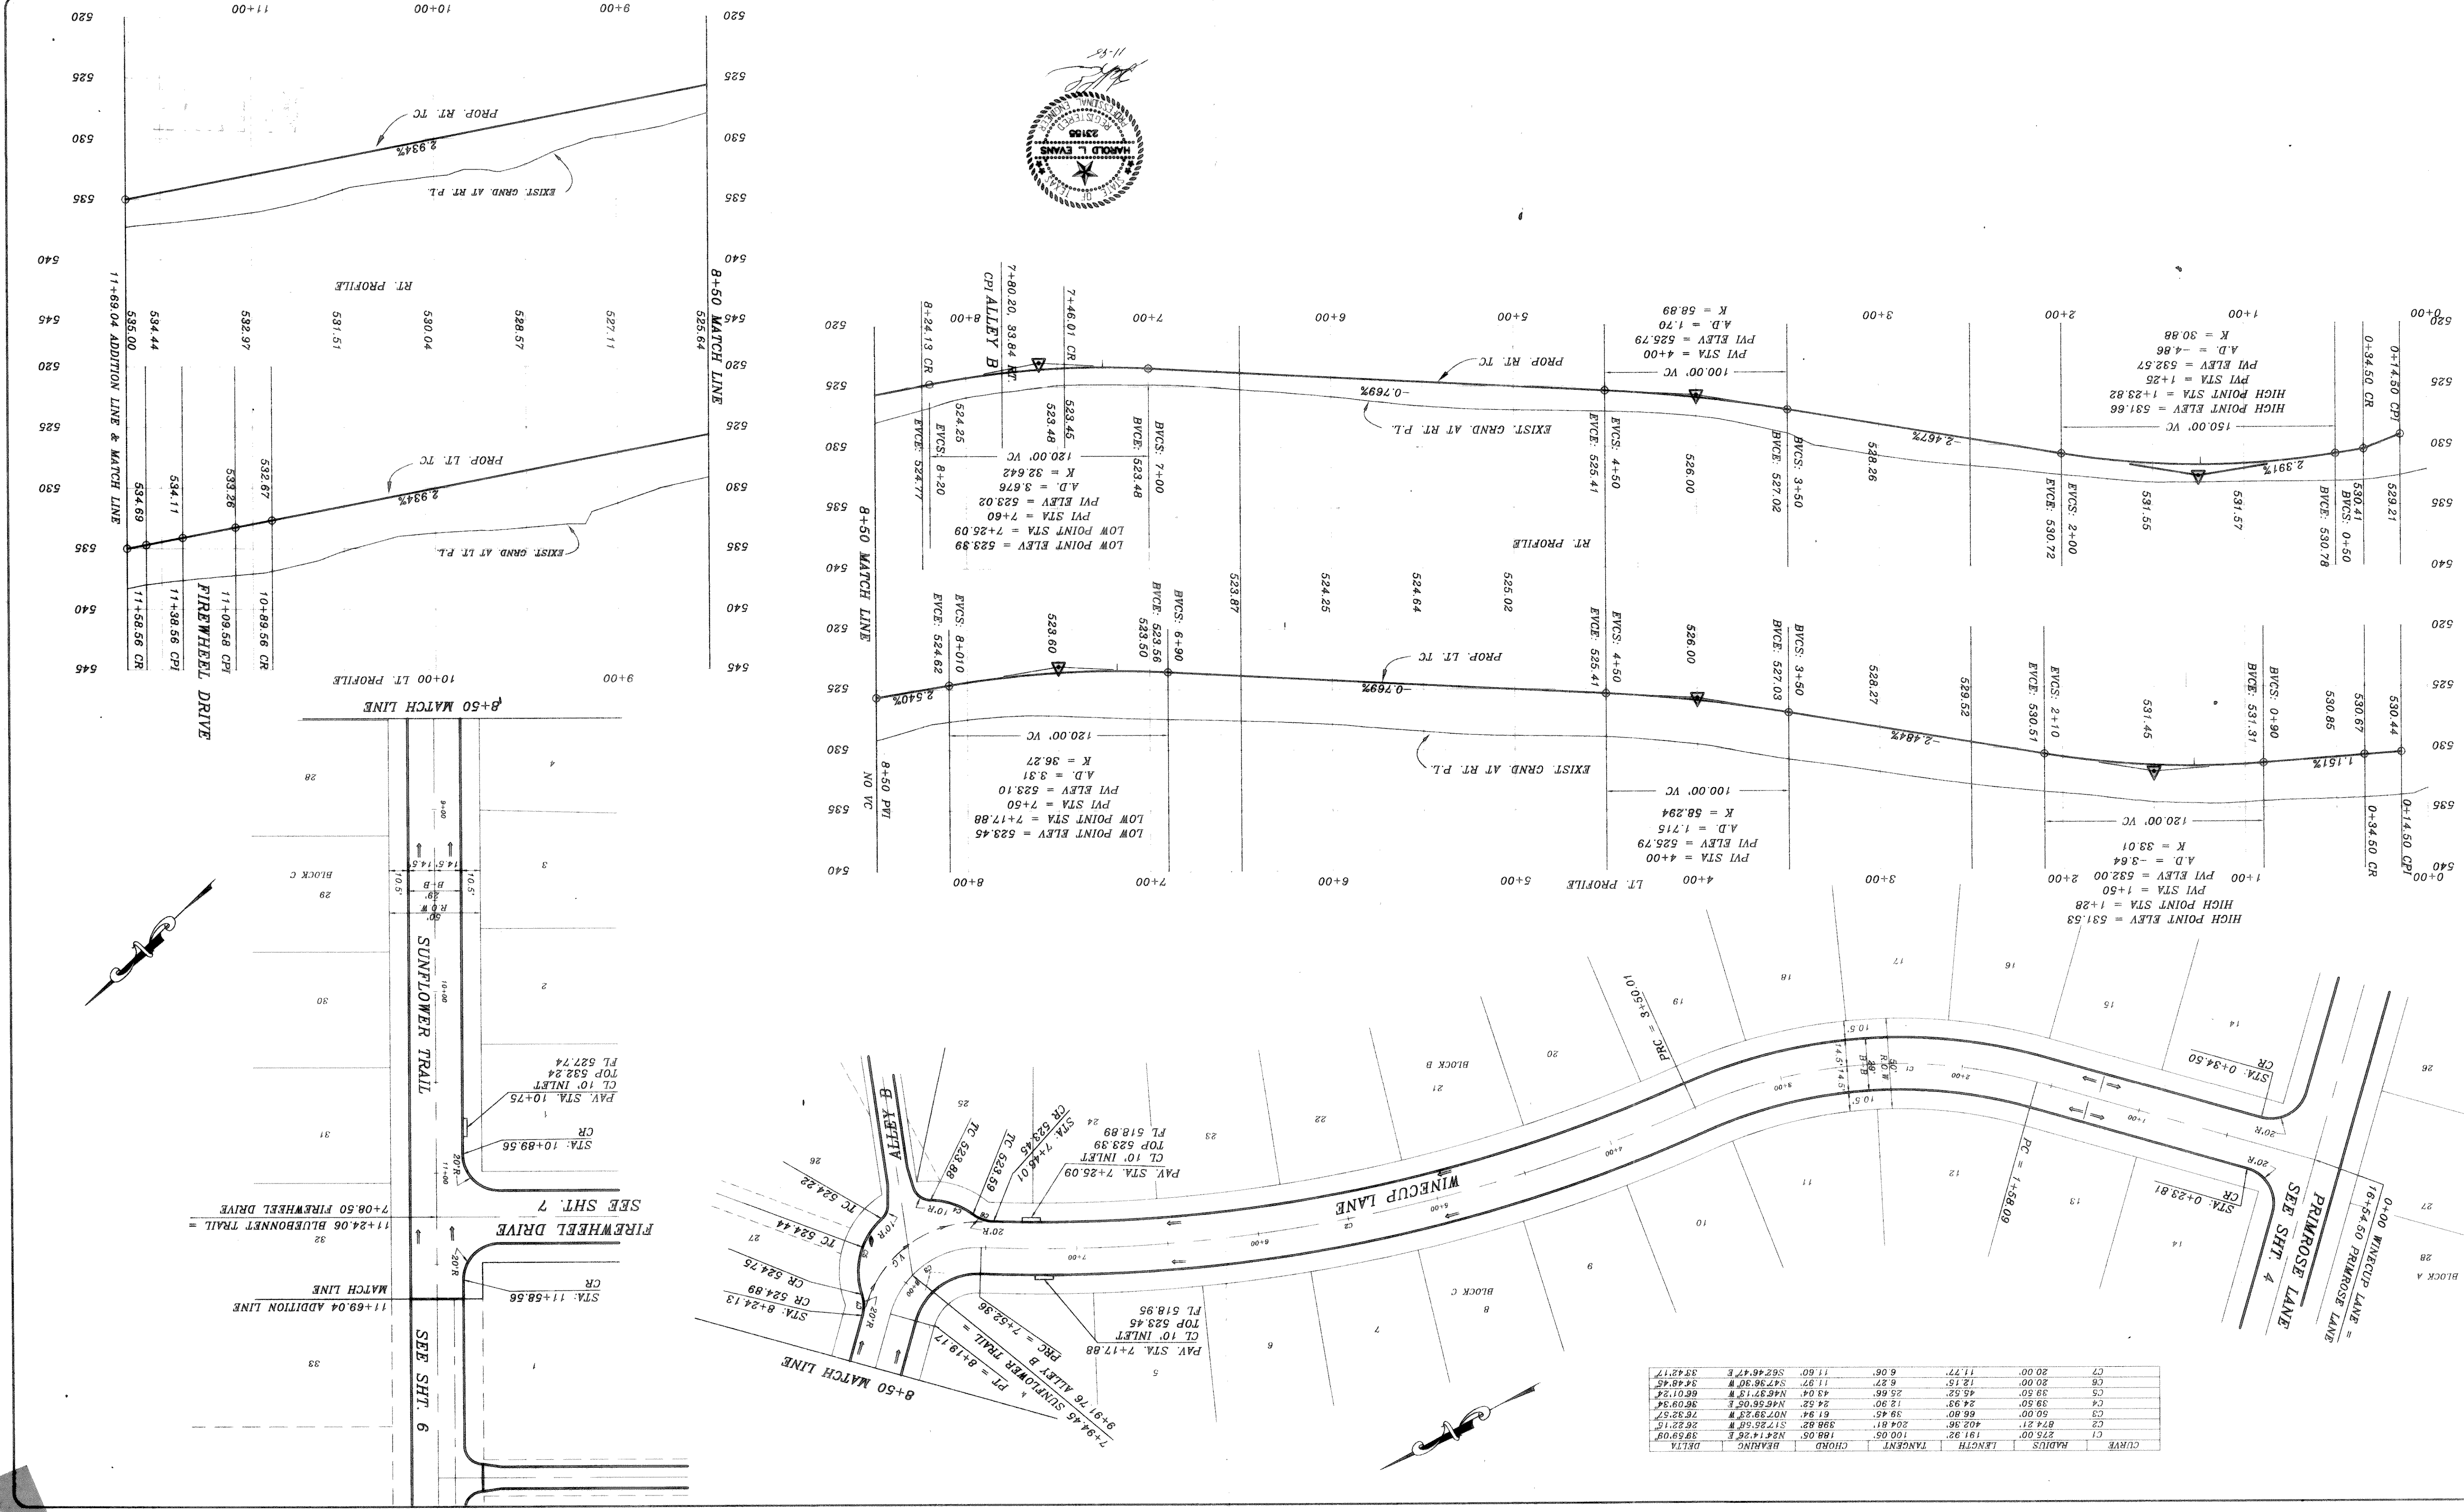