


TOP OF EXIST. SAN. SER. M.H. ELEVATION = 515.72
 LOCATED AT PAV. STA. - (0+25), 4' LT. WILLOWER PAV.
 M.H.
 TOP OF EXIST. M.H. AT WEST CORNER OF LOT 20, BLOCK A OF HIGHLAND MEADOWS ELEVATION = 514.85



PROPOSED PAVING

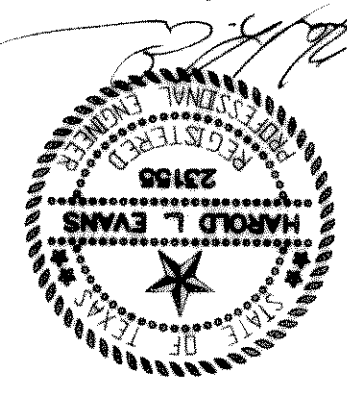