

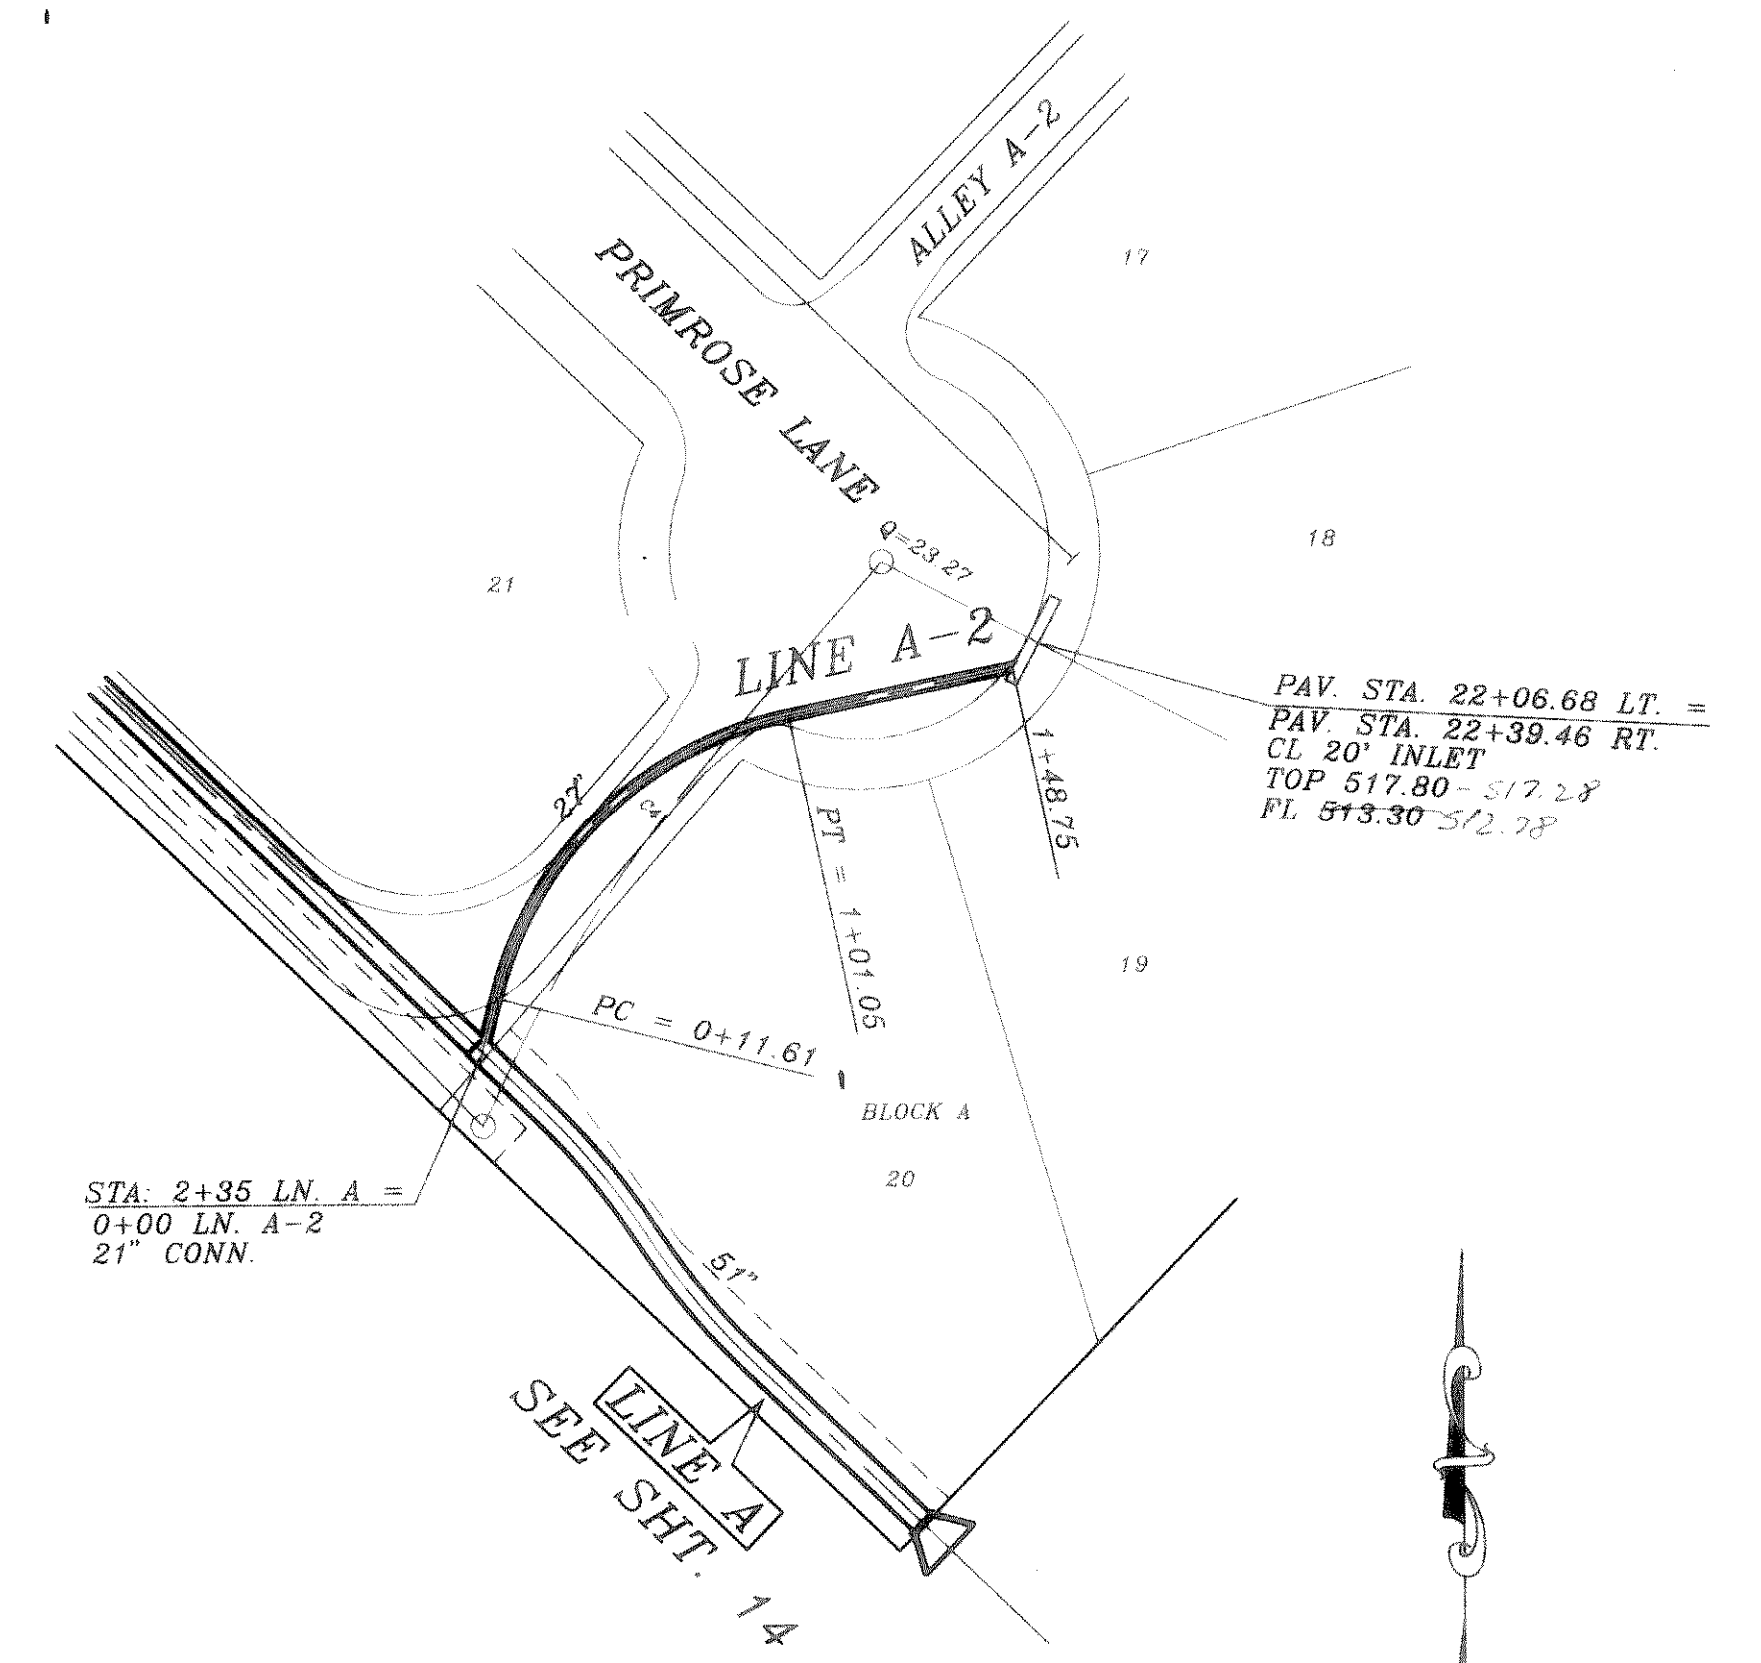



CURVE	RADIUS	LENGTH	TANGENT	CHORD	BEARING	DELTA
C1	104.50'	52.14'	26.62'	51.60'	S29°56'29" W	28°35'03"
C2	80.00'	20.62'	10.31'	20.57'	N36°50'32" E	14°46'14"
C3	104.50'	52.14'	26.62'	51.60'	S29°56'29" W	28°35'03"
C4	80.00'	89.44'	50.05'	84.86'	S46°15'45" W	64°03'30"

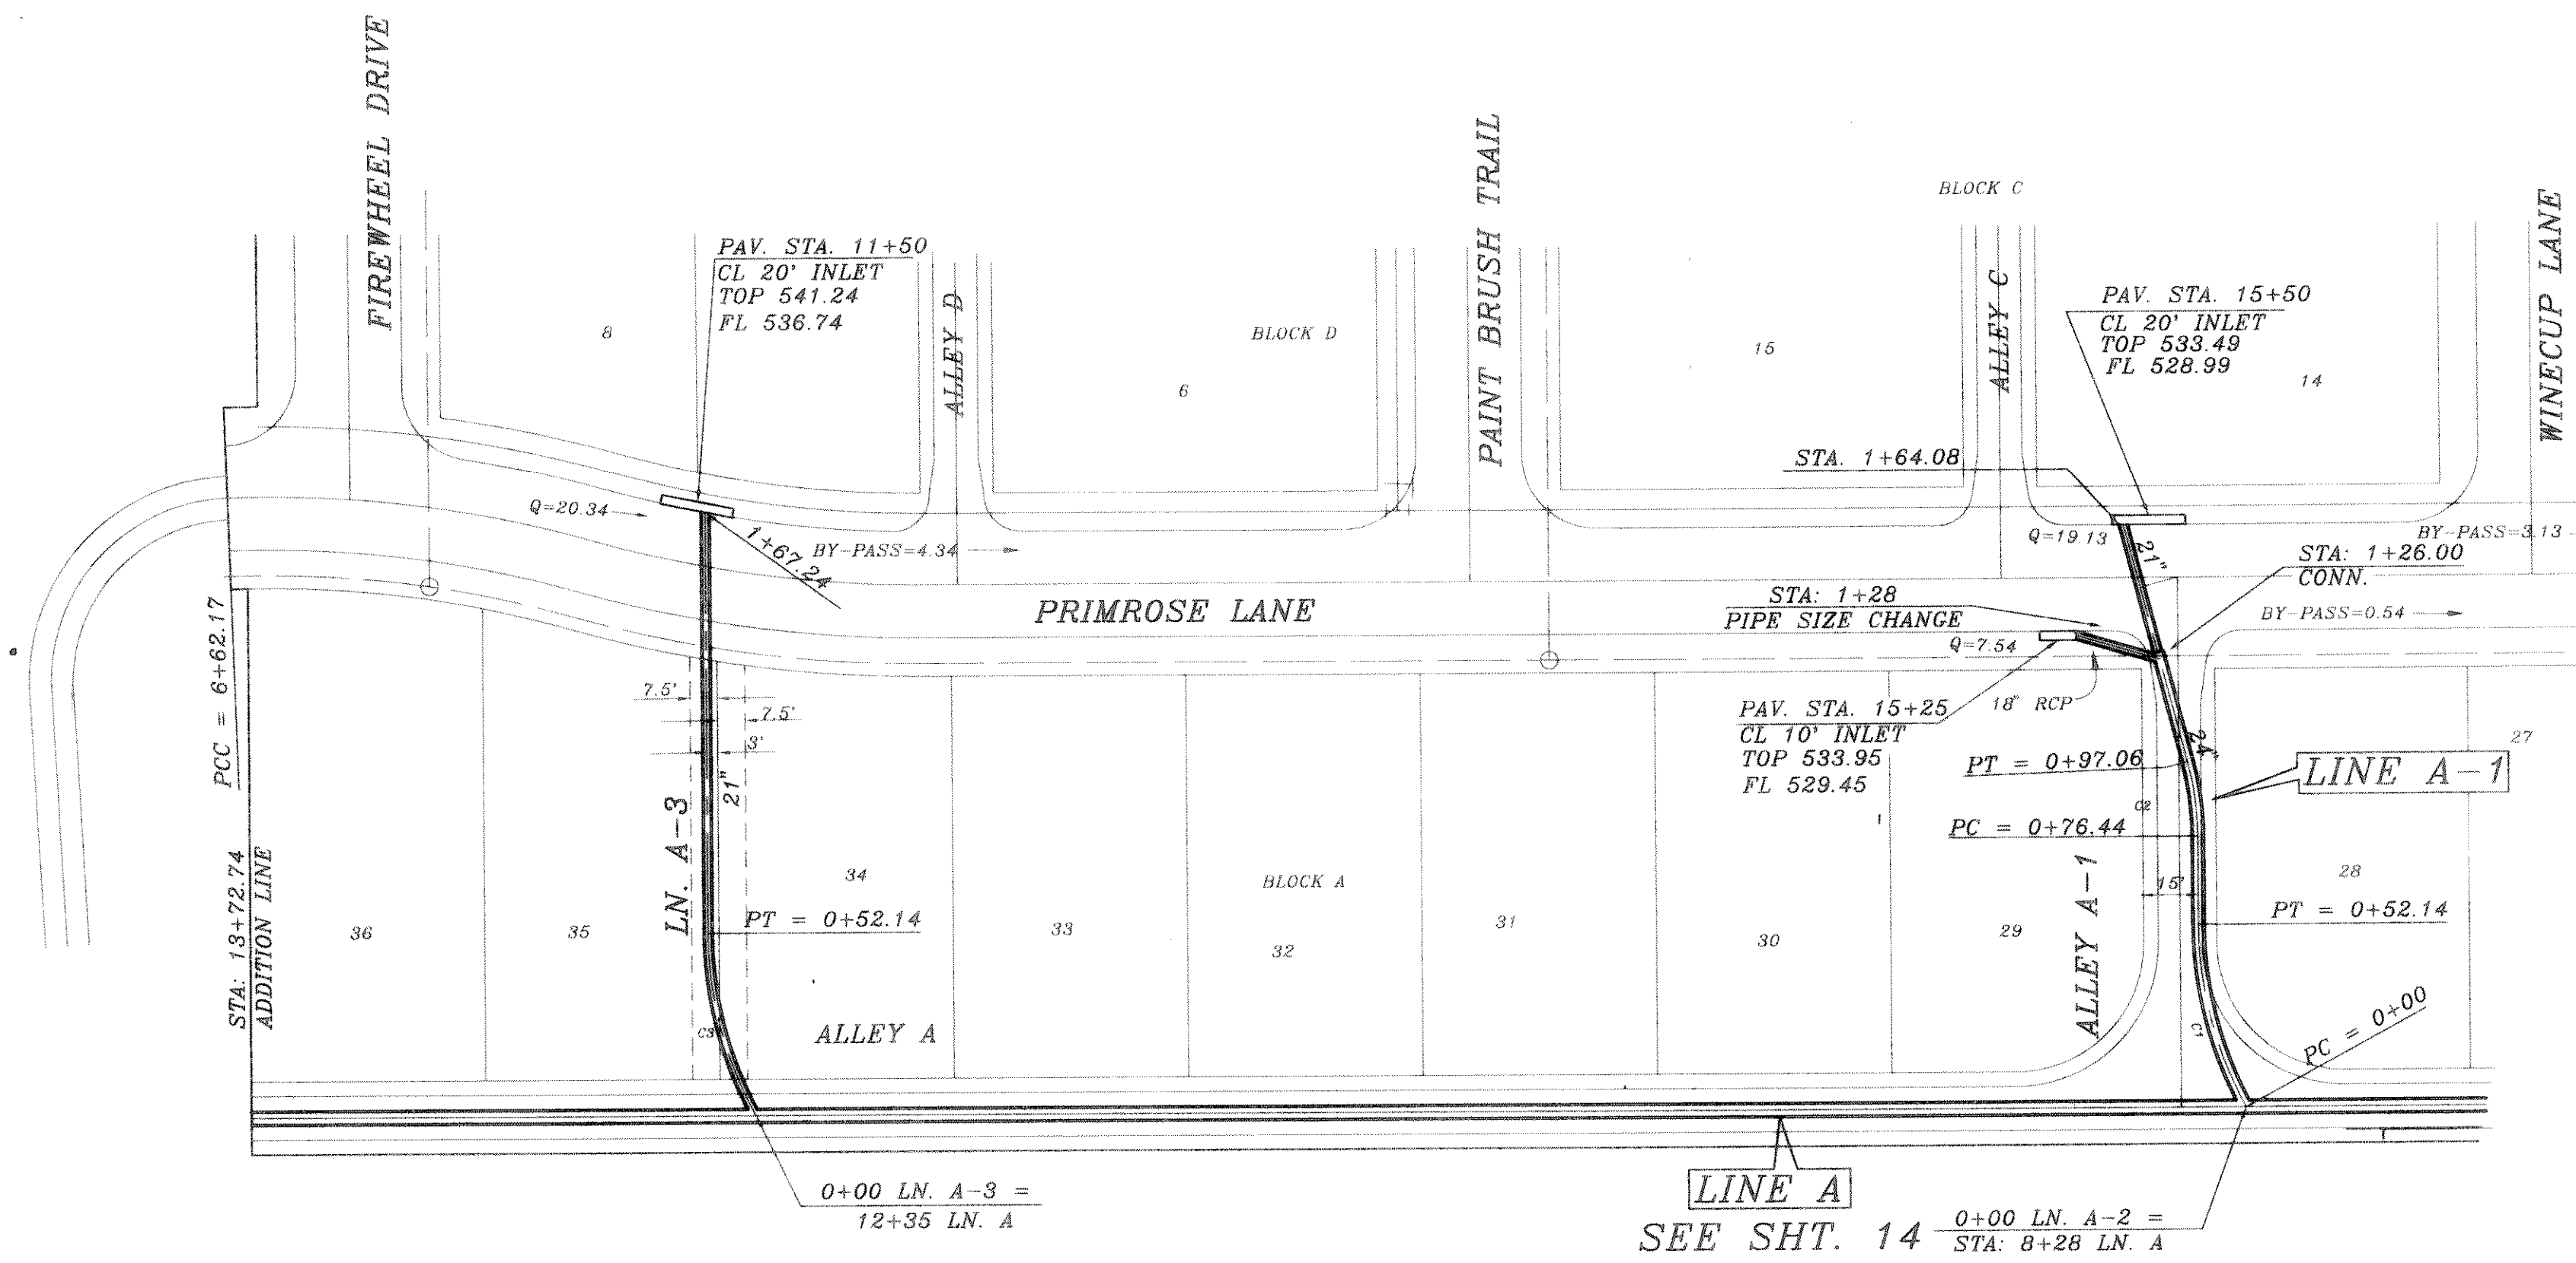


LINE A-3

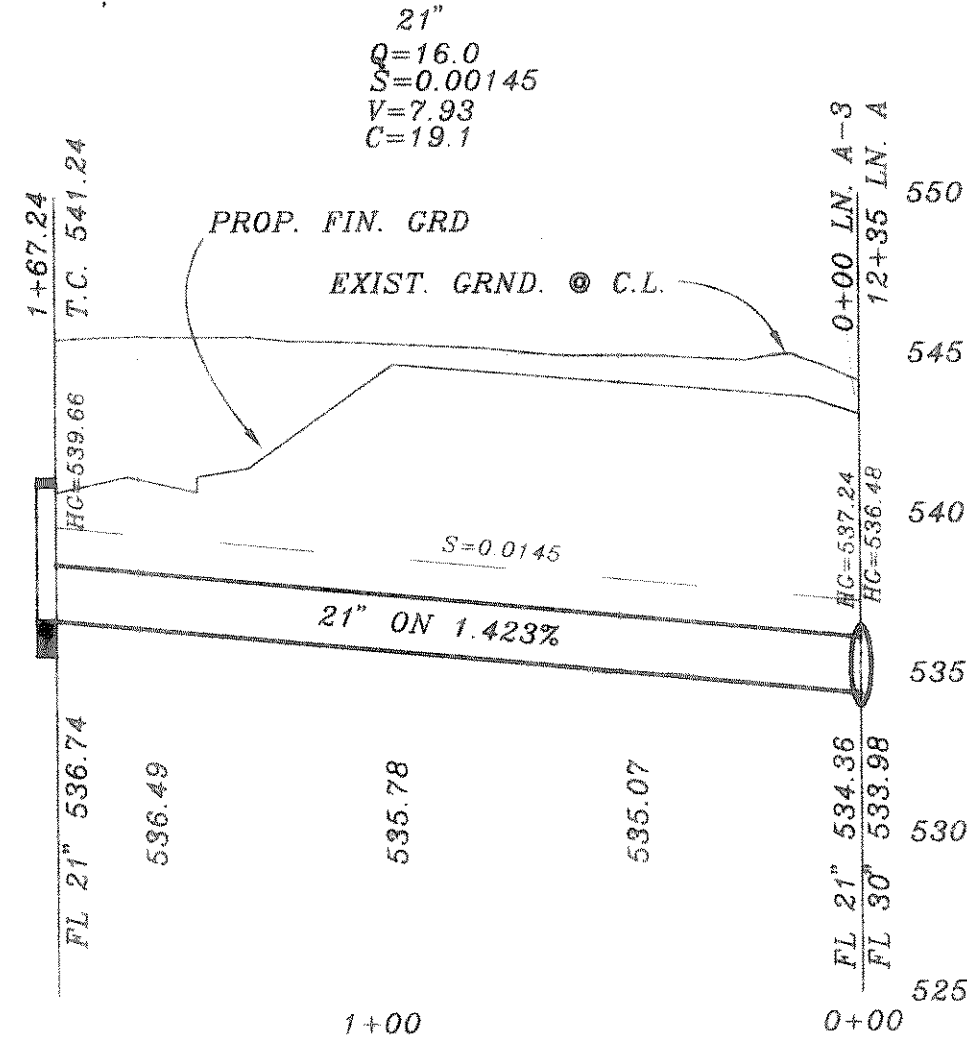

LINE A-1

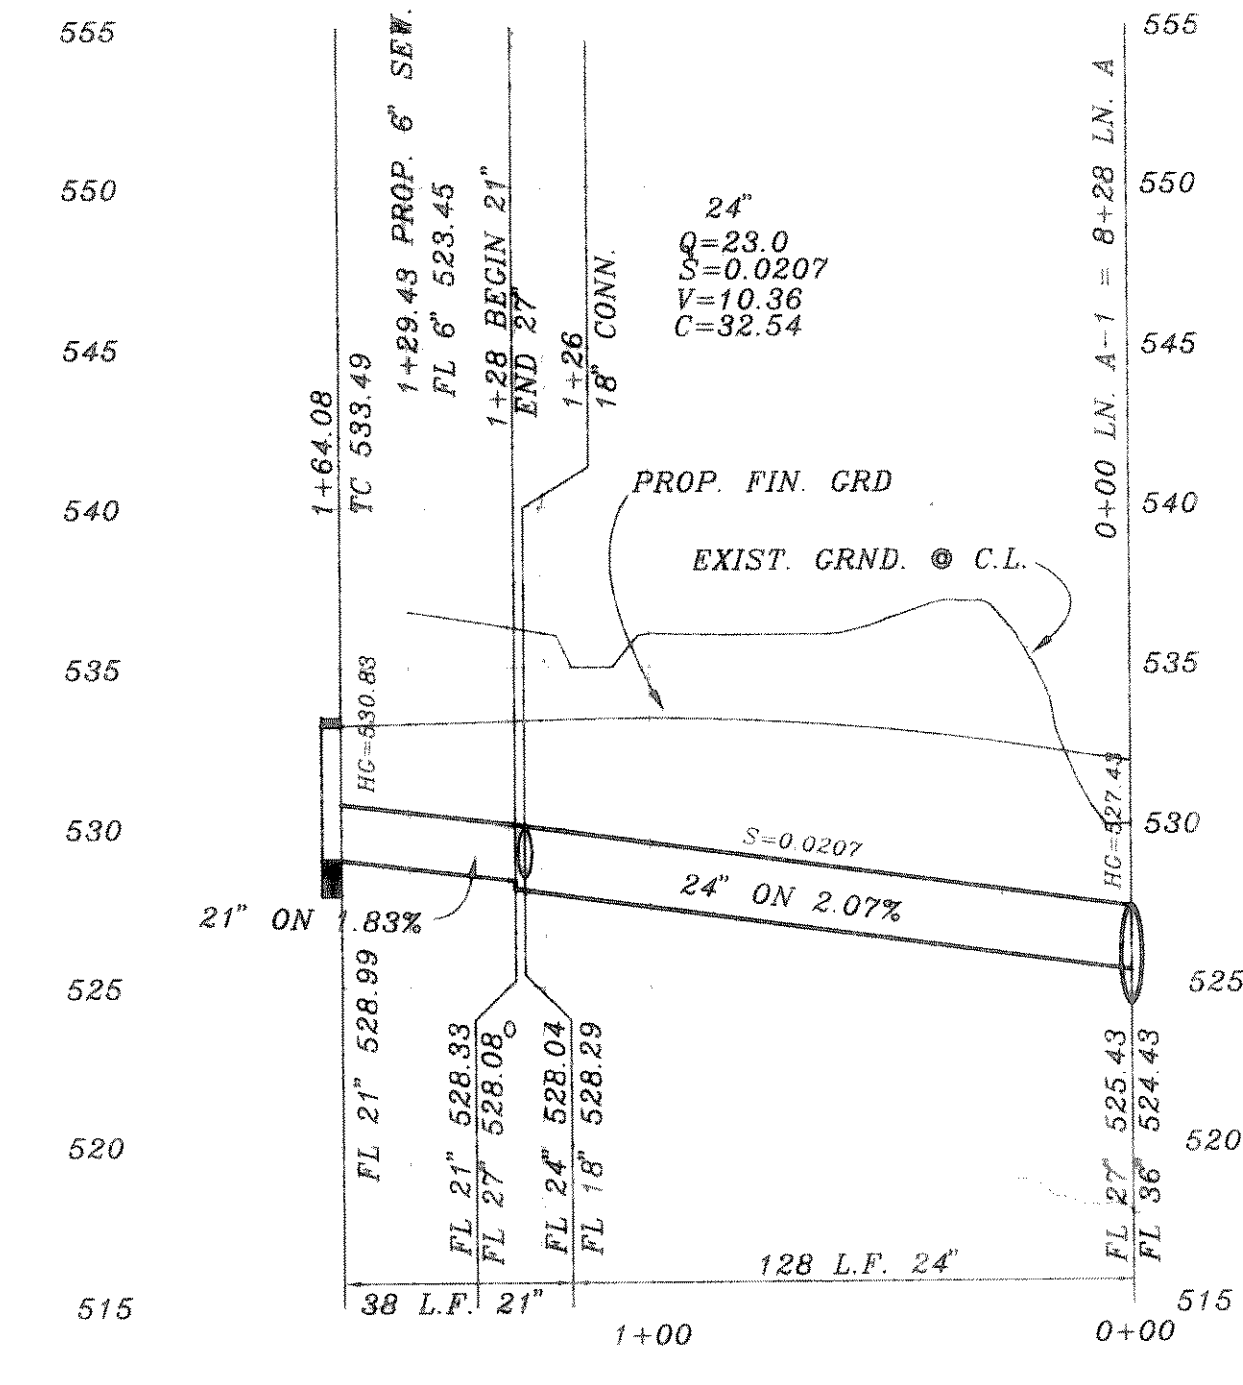

LINE A-2

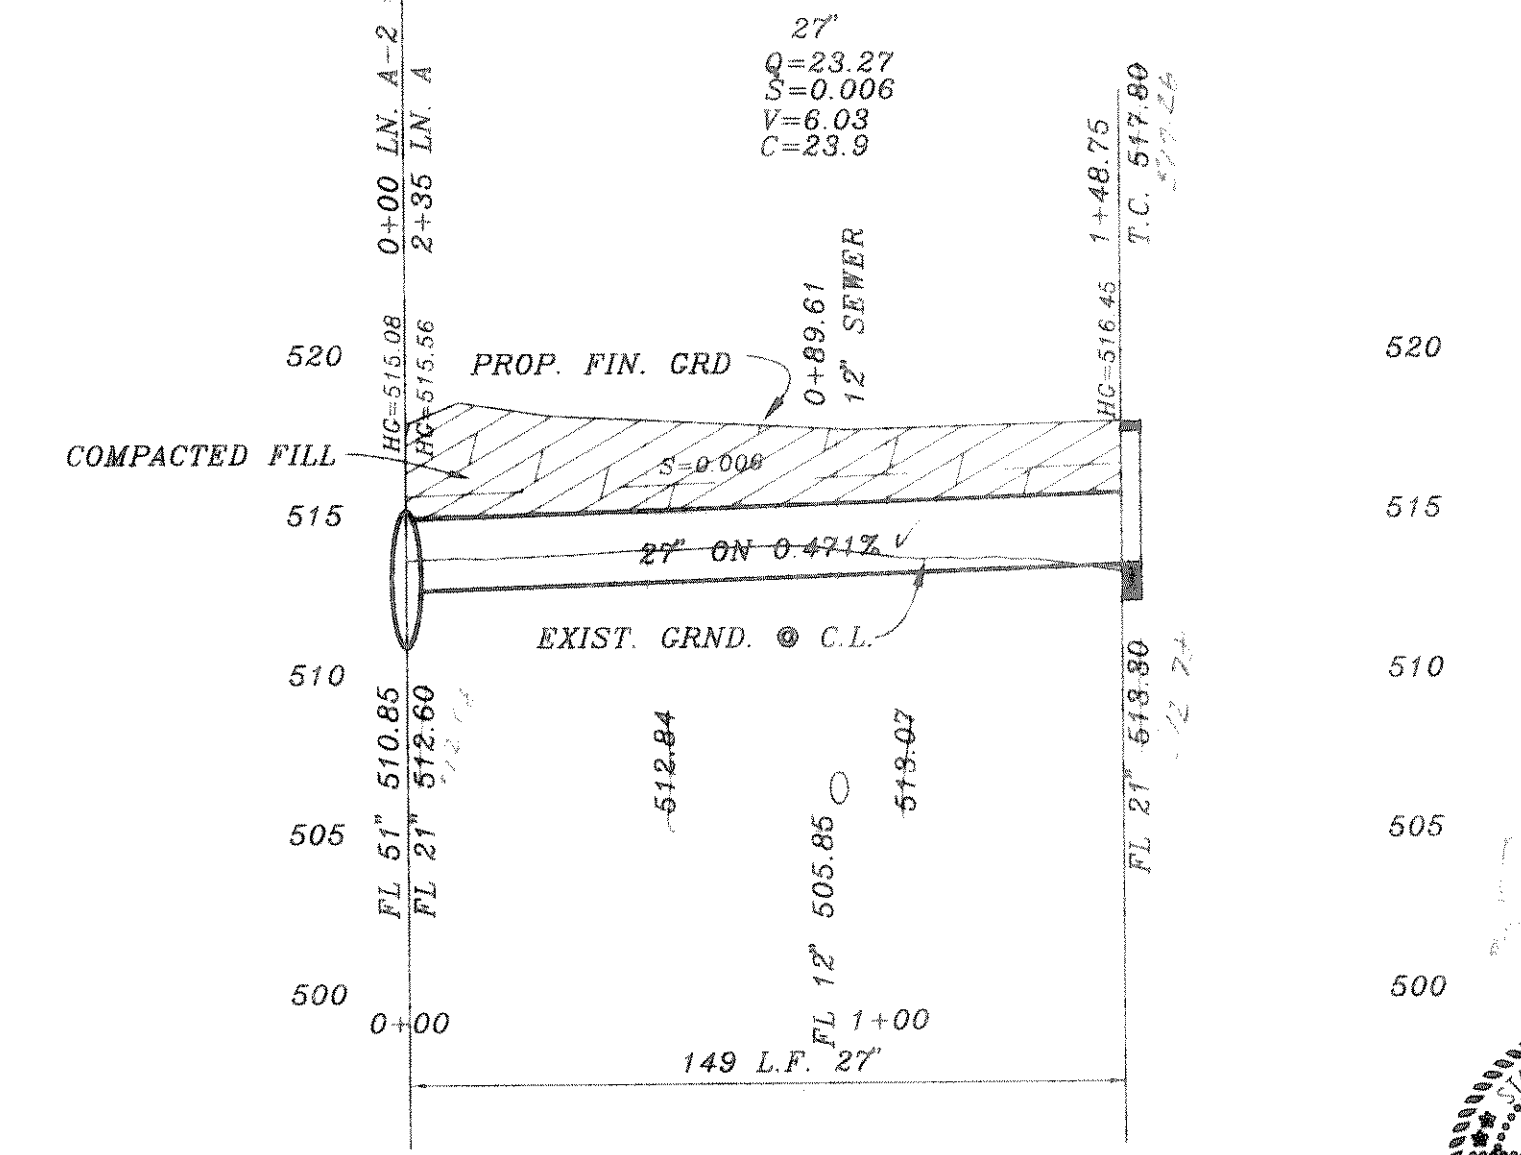

B.M.
TOP OF EXIST. SAN. SEW. M.H.
LOCATED AT PAV. STA. -(0+26), 4' LT.
WILDFLOWER WAY
ELEVATION = 515.72

B.M.
TOP OF EXIST. M.H. AT WEST
CORNER OF LOT 20, BLOCK A, OF
HIGHLAND MEADOWS
ELEVATION = 514.85

05632MS REV 1/3/96 REV PER 2nd CITY REVIEW 11/6/95 ADDED LN. A-3 10/13/95 REV PER CITY REVIEW 8/14/95		HAROLD L. EVANS CONSULTING ENGINEER P.O. BOX 28355 2331 GUS THOMASSON ROAD, SUITE 102 DALLAS, TEXAS 75228, (214) 328-8133		SHEET NO. 15 23 JOB NO. 9563	
REVISION DESCRIPTION 7/20/95		SCALE 1" = 40' 1" = 6'		DESIGN H.L.E.	
STORM SEWER LINES A-1 & A-2 HIGHLAND MEADOWS NO. 1 CITY OF ROCKWALL					

