


AS BUILT

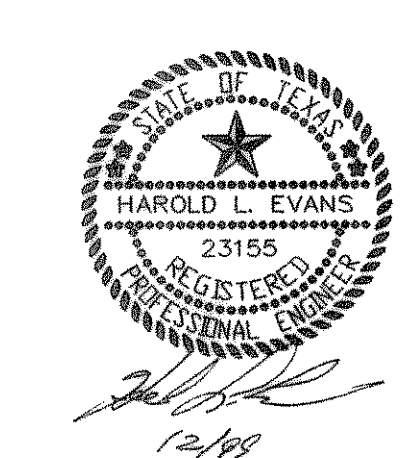

HAROLD L. EVANS CONSULTING ENGINEER 2331 GUS THOMASSON ROAD, SUITE 102 DALLAS, TEXAS 75228, (214) 386-8133		PAVING PLAN PRIMROSE LANE HIGHLAND MEADOWS NO. 2 CITY OF ROCKWALL		SHEET NO. 4 16 JOB NO. 9957
REVISION DESCRIPTION 9857PVZ	DATE Sept., 1999	SCALE 1" = 40' 1" = 8'	DESIGN H.L.E.	DRAWN L.W.G.