


AS BUILT

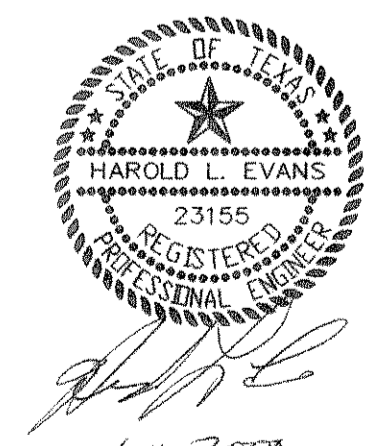

REVISION DESCRIPTION	DATE
REV. TO LN. A,K,&L	01/14/00
REV. PER 2nd CITY REVIEW	10/25/99
REV. PER CITY REVIEW	10/25/99

**HAROLD L. EVANS**  
CONSULTING ENGINEER  
P.O. BOX 28355  
2331 CUS THOMASSON ROAD, SUITE 102  
DALLAS, TEXAS 75228, (214) 328-8133

SCALE  
1" = 50'  
1" = 6'

DESIGN  
H.L.E.

DRAWN

**PROPOSED SEWER PROFILES**

**HIGHLAND MEADOWS No. 2**  
CITY OF ROCKWALL

SHEET NO.  
13  
16

JOB NO.  
9957