


CONST. SCREENING WALL ALONG MIMS ROAD FROM END OF EXIST. WALL NEAR STA. 12+50 TO STA. 18+88 SEE DETAIL A BELOW

CONST. 4\"/>

AS BUILT

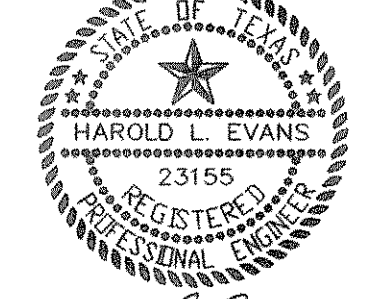

H.L.E.
12/89

Rev.	DATE
1	12/9/89
2	11/30/89
3	11/17/89
4	10/25/89

HAROLD L. EVANS
CONSULTING ENGINEER
P.O. BOX 28355
2331 CUS THOMASSON ROAD, SUITE 102
DALLAS, TEXAS 75228, (214) 328-8133

LOT GRADING PLAN
HIGHLAND MEADOWS NO. 2
CITY OF ROCKWALL

SHEET NO.
15
18
JOB NO.
9957