


AS BUILT

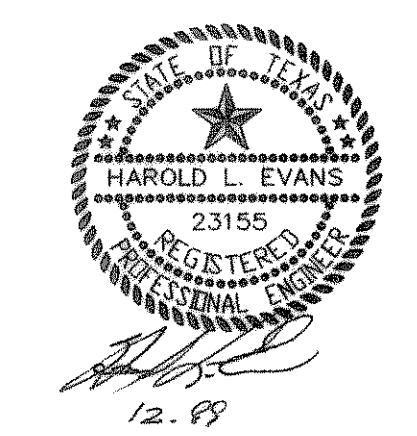

HAROLD L. EVANS CONSULTING ENGINEER P.O. BOX 28355 2331 CUS THOMASSON ROAD, SUITE 102 DALLAS, TEXAS 75228, (214) 328-8133		SHEET NO. 5 16
PAVING PLAN GOLDEN WAVE DRIVE & ANGIE LANE HIGHLAND MEADOWS NO.2 CITY OF ROCKWALL		
REV. CRDS - GOLDEN WAVE DRIVE REV. CRDS AT EXIST. PAV. REV. PER CITY REVIEW	12/31/99 11/30/99 10/25/99	JOB NO. 9957
REVISION DESCRIPTION	DATE: Sept., 1999 SCALE: 1" = 40' 1" = 6' DESIGN: H.L.E. DRAWN: L.W.C.	