


AS BUILT

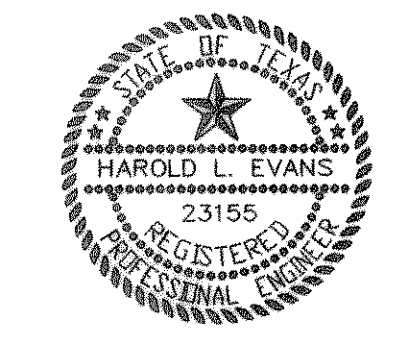

<b>HAROLD L. EVANS</b> CONSULTING ENGINEER P.O. BOX 28955 2331 GUS THOMASSON ROAD, SUITE 102 DALLAS, TEXAS 75228, (214) 328-8133	
REV. GRDS. ALLEY E & ALLEY F. REV. GRDS. AT EXIST. PAV. ALLEY E	12/31/99 11/20/99
REVISION DESCRIPTION 9957PV7	DATE: Sept., 1999 SCALE: 1" = 40', 1" = 6' DESIGN: H.L.E. DRAWN: L.W.G.

PAVING PLAN ALLEY E AND F HIGHLAND MEADOWS NO. 2 CITY OF ROCKWALL
--

SHEET NO. 8
16
JOB NO. 9957