


AS BUILT

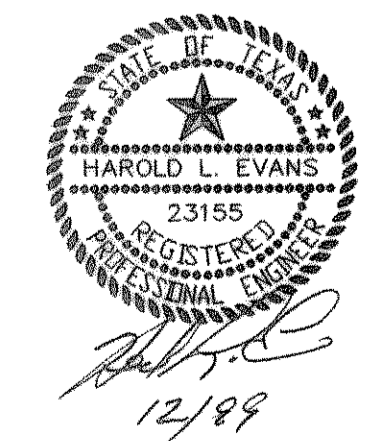

REVISION DESCRIPTION		DATE	SCALE	DESIGN	DRAWN
REV. CRDS. AT EXIST. PAV.		11/30/89	1" = 40' 1" = 8'	H.L.E.	L.W.G.

HAROLD L. EVANS
 CONSULTING ENGINEER
 P.O. BOX 28355
 2331 GUS THOMASSON ROAD, SUITE 102
 DALLAS, TEXAS 75228, (214) 388-8133

PAVING PLAN
ALLEY E A, I, AND G
HIGHLAND MEADOWS NO. 2
CITY OF ROCKWALL

SHEET NO.	9
JOB NO.	9957