

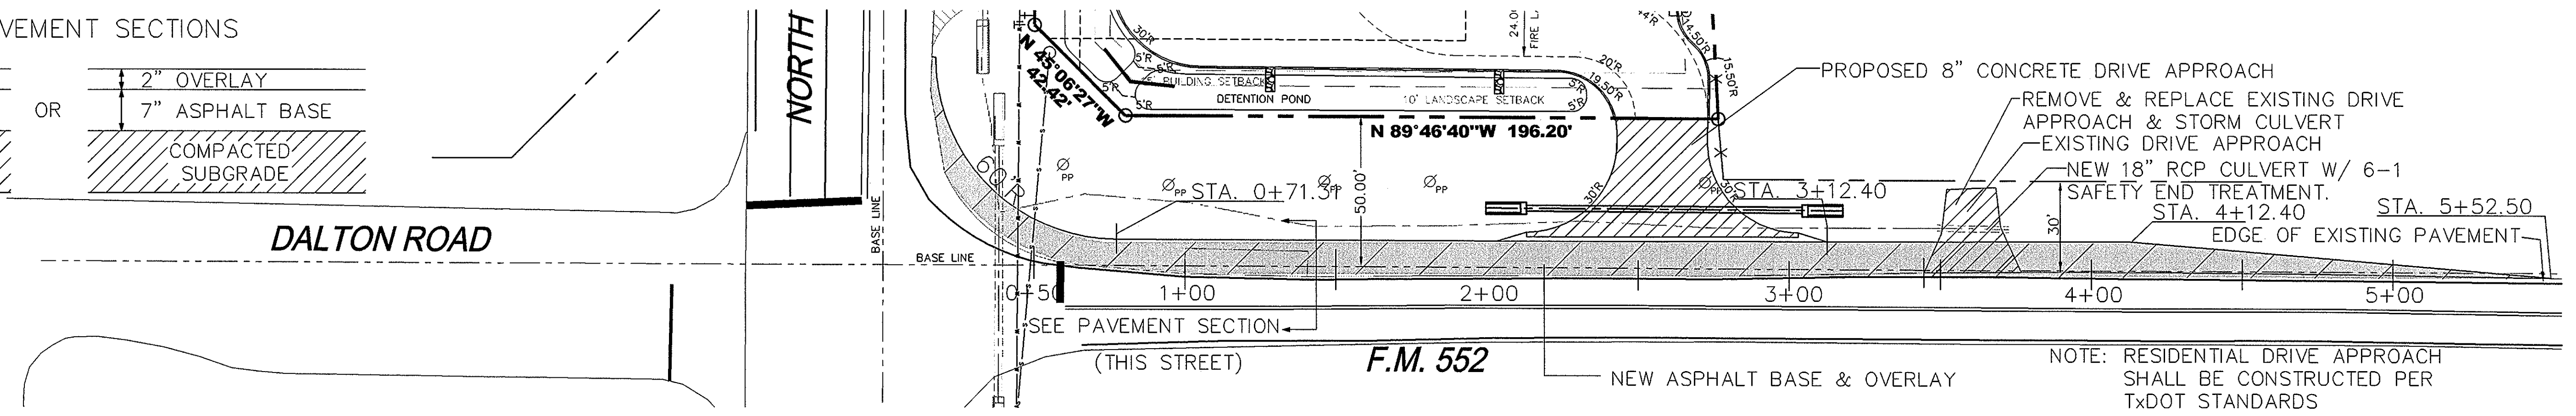



PAVING DEMOLITION PLAN

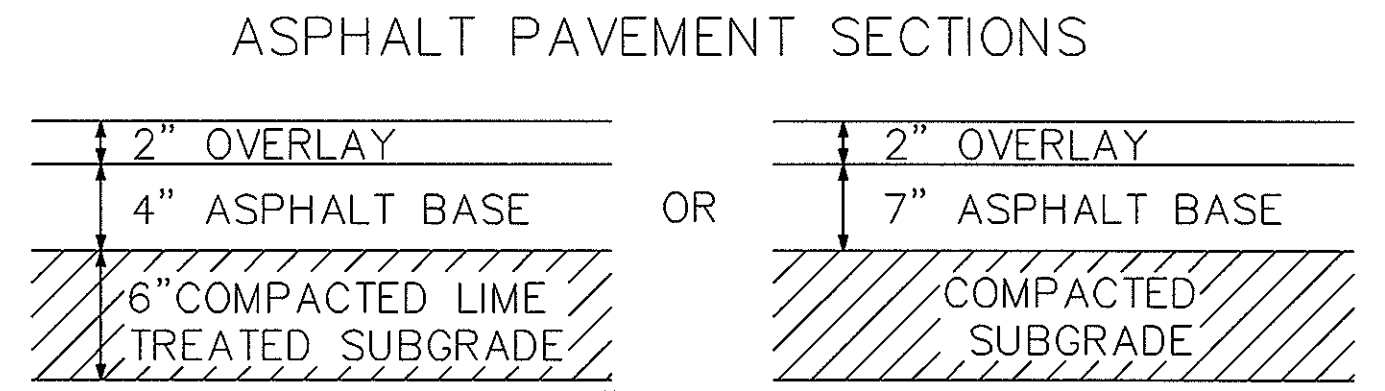

PAVING PLAN

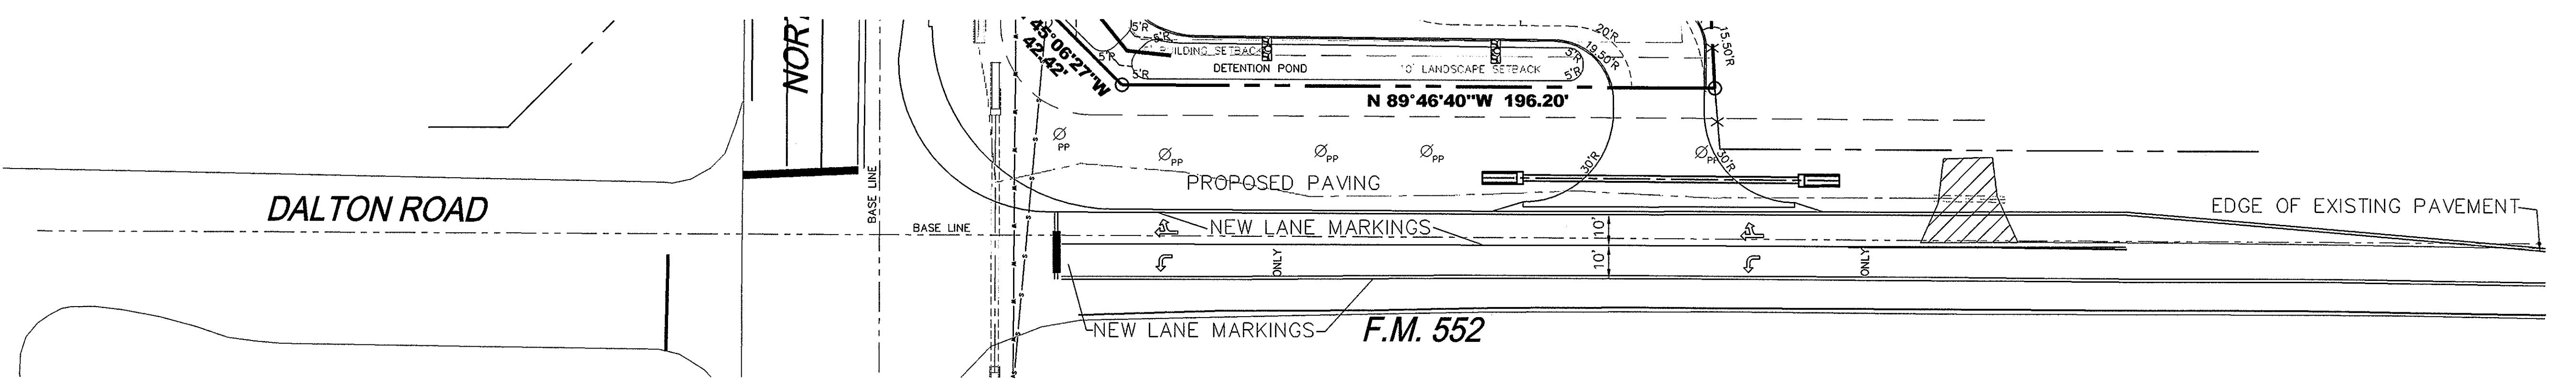

STRIPING PLAN

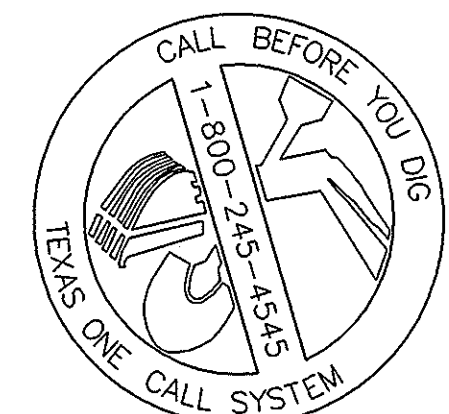

LEGEND	
---	SAWCUT (@ 12' MIN - 15'MAX.)
[Pattern]	4" THICK ASPHALT PAVEMENT 2500 P.S.I.
[Pattern]	6" THICK ASPHALT PAVEMENT 4000 P.S.I.
[Pattern]	8" THICK ASPHALT PAVEMENT 4000 P.S.I.


No.	DATE	REVISION / DESCRIPTION	BY	No.	DATE	REVISION / DESCRIPTION	BY

THE DIMENSION GROUP
 CIVIL ENGINEERING • LAND DEVELOPMENT • PLANNING • ARCHITECTURE • CONSTRUCTION MANAGEMENT
 10755 SANDHILL ROAD, DALLAS, TEXAS 75238 TEL: 214-343-9400 FAX: 214-341-9000

PROJECT INFO.
 7-ELEVEN
 N.E.C. OF N. GOLIAD STREET
 & FM 552
 ROCKWALL, TEXAS

DRAWING INFO.
 AS-BUILT
 OFFSITE PAVING
 F.M. 552

PROJECT No. 06127
 DATE: 05/18/07
 DRAWN BY: CS
 CHECKED BY: RA

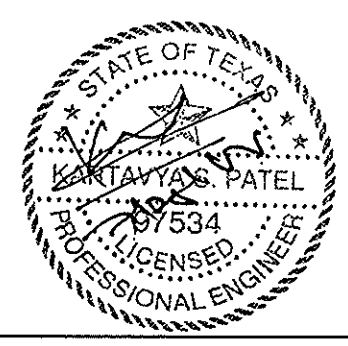

SHEET NUMBER
 C5.2

7-ELEVEN - N.E.C. OF N. GOLIAD STREET (SH 205) & FM 552, ROCKWALL, TEXAS