


AS-BUILT

BENCHMARKS:  
 "X" cut in concrete on the center line of Sunset Hill, Paving Sta. +0+10 Elev. 552.96  
 "X" cut in concrete on the center line intersection of North Lake Shore Dr. with North Hills Drive. Elev. 515.64

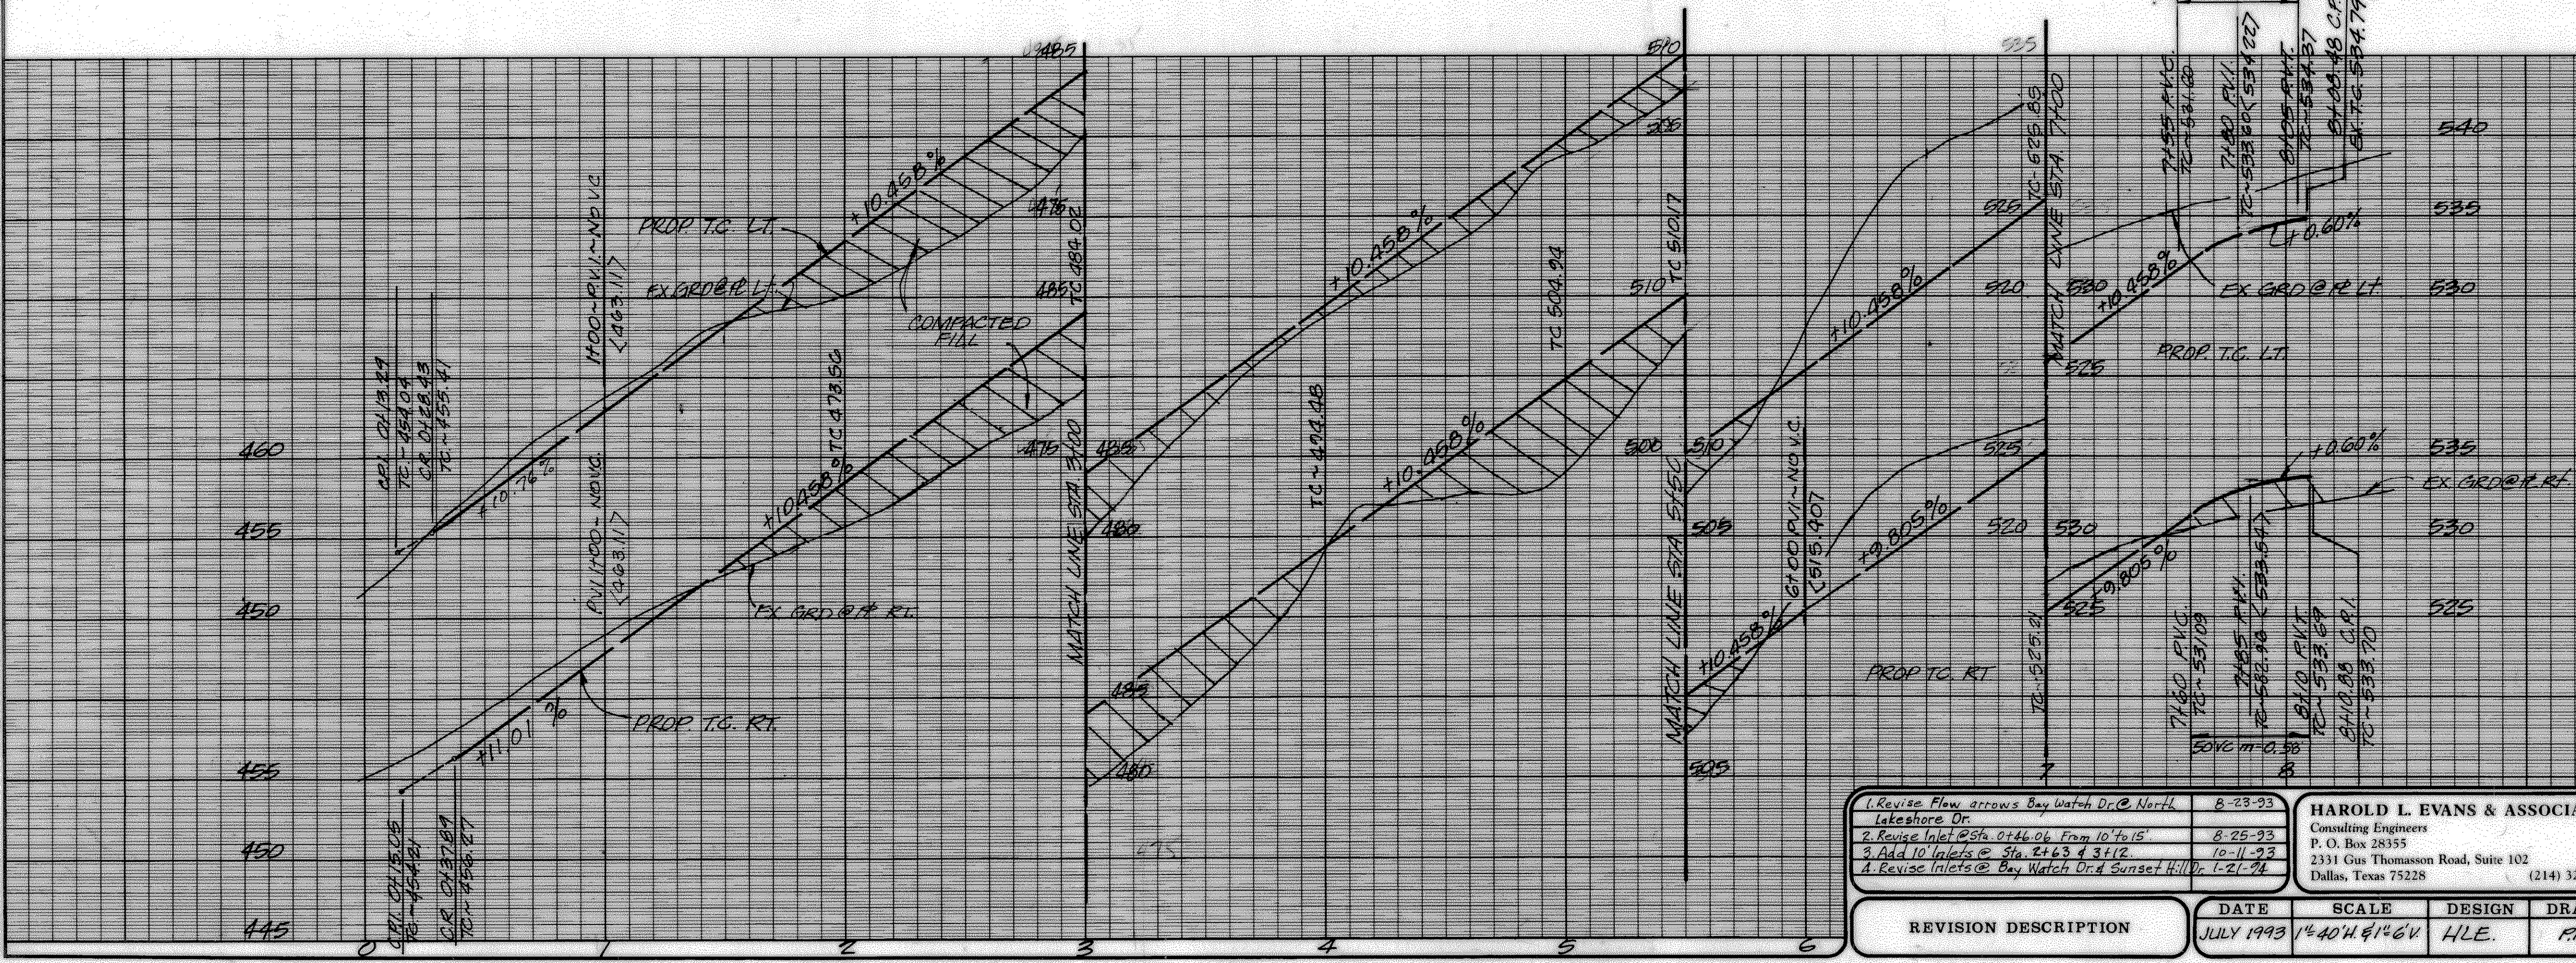

REVISION DESCRIPTION	DATE
1. Revise Flow arrows Bay Watch Dr. @ North Lakeshore Dr.	8-23-93
2. Revise Inlet 2 Sta. 0+44.04 From 10' to 15'	8-26-93
3. Add 10' Inlets @ Sta. 2+463 & 3+112	10-11-93
4. Revise Inlets @ Bay Watch Dr. & Sunset Hill Dr.	1-21-94

HAROLD L. EVANS & ASSOCIATES  
 Consulting Engineers  
 P. O. Box 28355  
 2331 Gus Thomasson Road, Suite 102  
 Dallas, Texas 75228 (214) 328-8133

<b>PAVING PLANS</b>				<b>4</b> <b>18</b>
<b>BAY WATCH DRIVE</b>				
<b>HILLCREST SHORES</b>				
<b>ROCKWALL, ROCKWALL COUNTY, TEXAS</b>				JOB NO. 9323