


CAN CUT REMOVE & REPLACE 18" X 6" LF OF CONC. CURB & GUTTER & CONN. TO EXPOSED REBARS

BENCHMARKS:  
 "X" cut in concrete on the center line of Sunset Hill, Paving Sta. -0+10 Elev. 452.96  
 "Y" cut in concrete on the center line intersection of North Lake Shore Dr. with North Hills Drive. Elev. 515.64

AS-BUILT

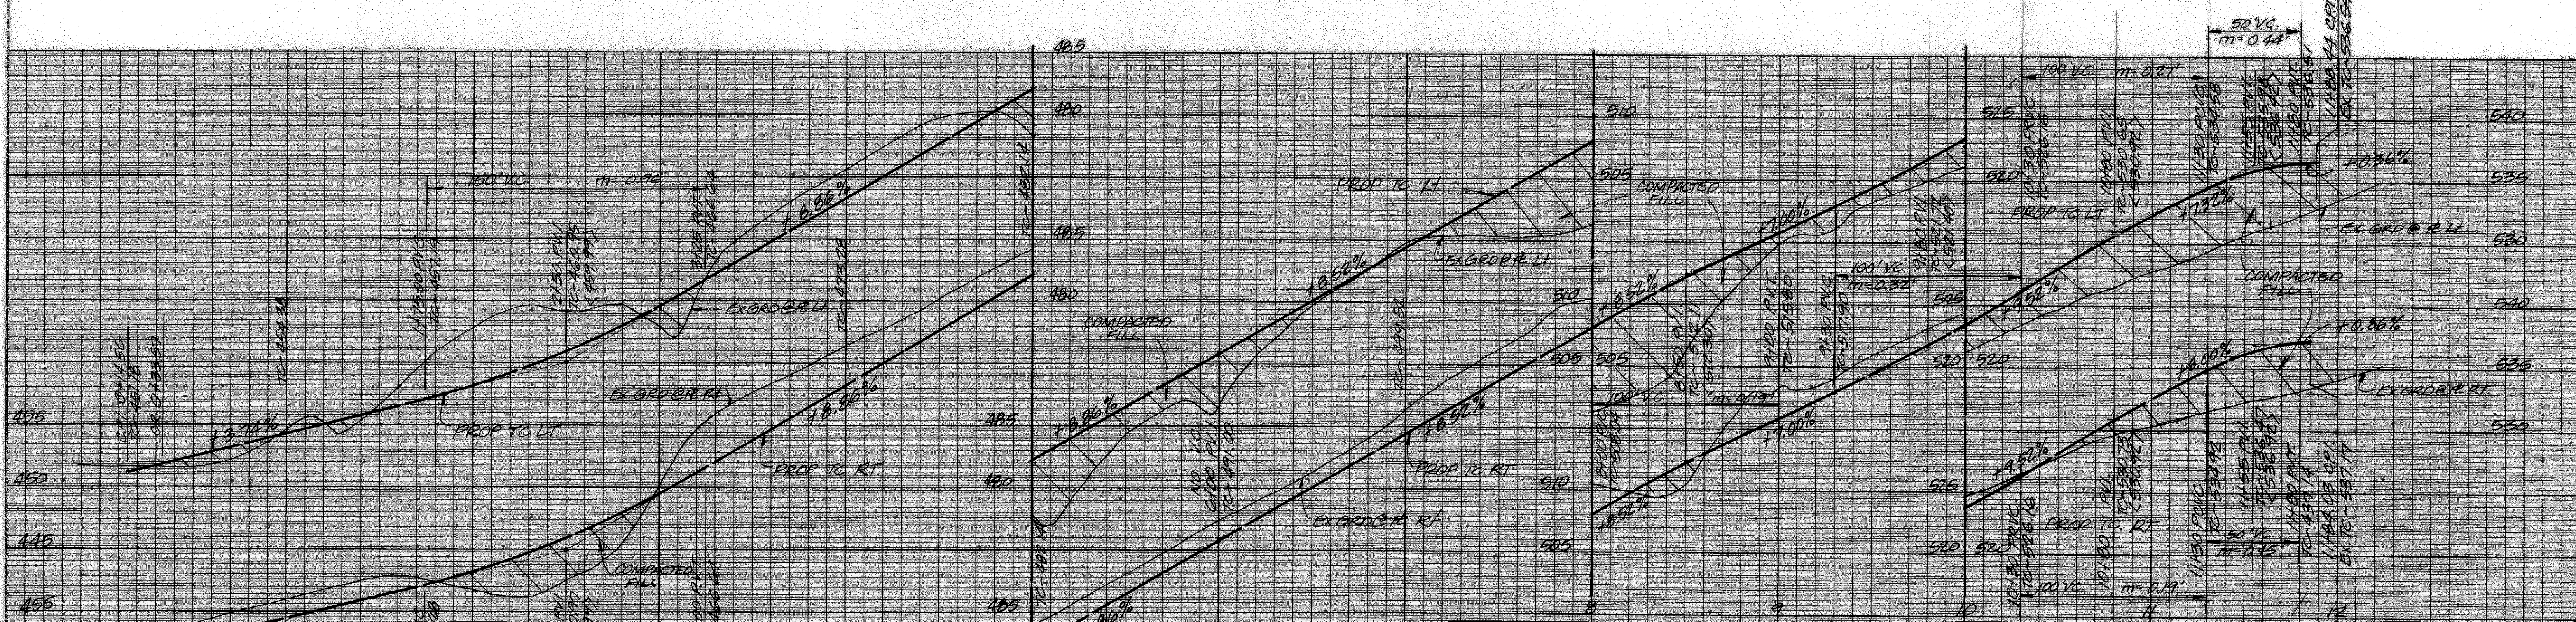

1 Add 2-10' Inlets @ Sta. 2+39 & 3+62	10-11-93
2 Revised Inlets @ Lake Breeze Dr. & Sunset Hill Dr.	1-21-94

HAROLD L. EVANS & ASSOCIATES  
 Consulting Engineers  
 P. O. Box 28355  
 2331 Gus Thomasson Road, Suite 102  
 Dallas, Texas 75228 (214) 328-8133

<b>PAVING PLANS</b>		SHEET NO. <b>5</b>
LAKE BREEZE DRIVE		
HILLCREST SHORES		JOB NO. <b>9323</b>
ROCKWALL, ROCKWALL COUNTY, TEXAS		

REVISION DESCRIPTION	DATE	SCALE	DESIGN	DRAWN
	JULY 1993	1"=40' H & 1"=6' V	H.L.E.	PN