


AS-BUILT  
 P-17-90

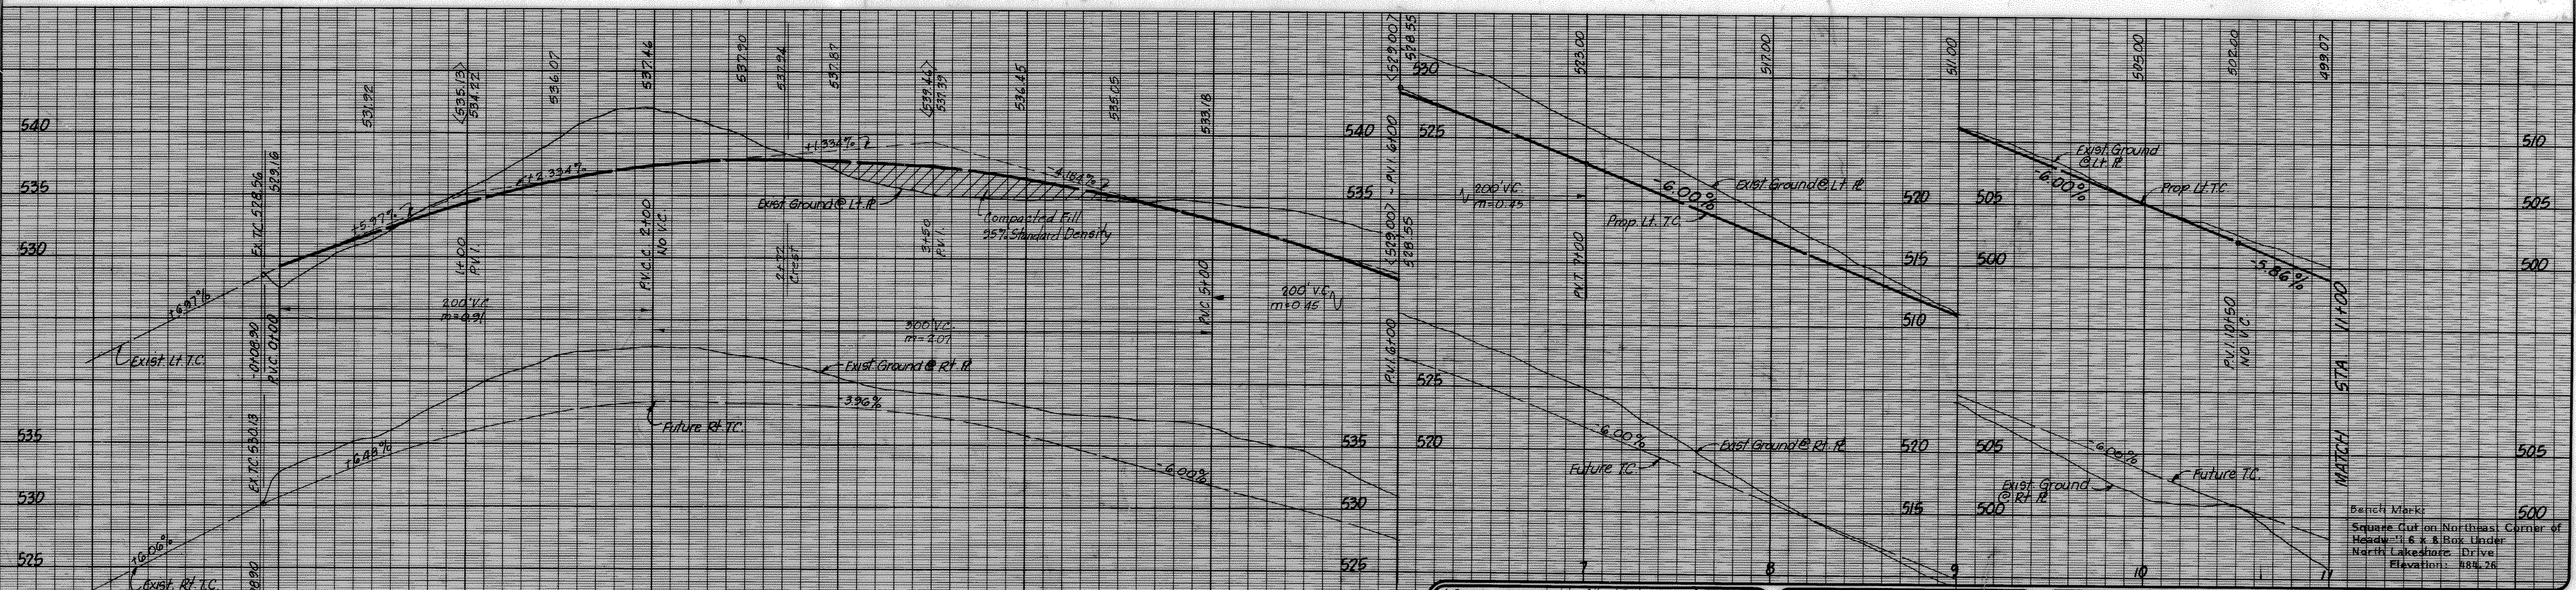

1. Revisions requested by City of Rockwall	9-06-90

**HAROLD L. EVANS**  
 Consulting Engineers  
 P. O. Box 28355  
 2331 Gus Thomasson Road, Suite 102  
 Dallas, Texas 75228 (214) 328-8133

**PAVING PLANS**  
**HILLCREST SHORES**  
**NORTH LAKESHORE DRIVE**  
**ROCKWALL, TEXAS**

REVISION DESCRIPTION	DATE	SCALE	DESIGN	DRAWN
	AUG, 1990	1" = 40' H. 1" = 6' V.	H.L.E.	G.S.

SHEET NO.  
**6**  
**18**  
 JOB NO.  
**9323**