
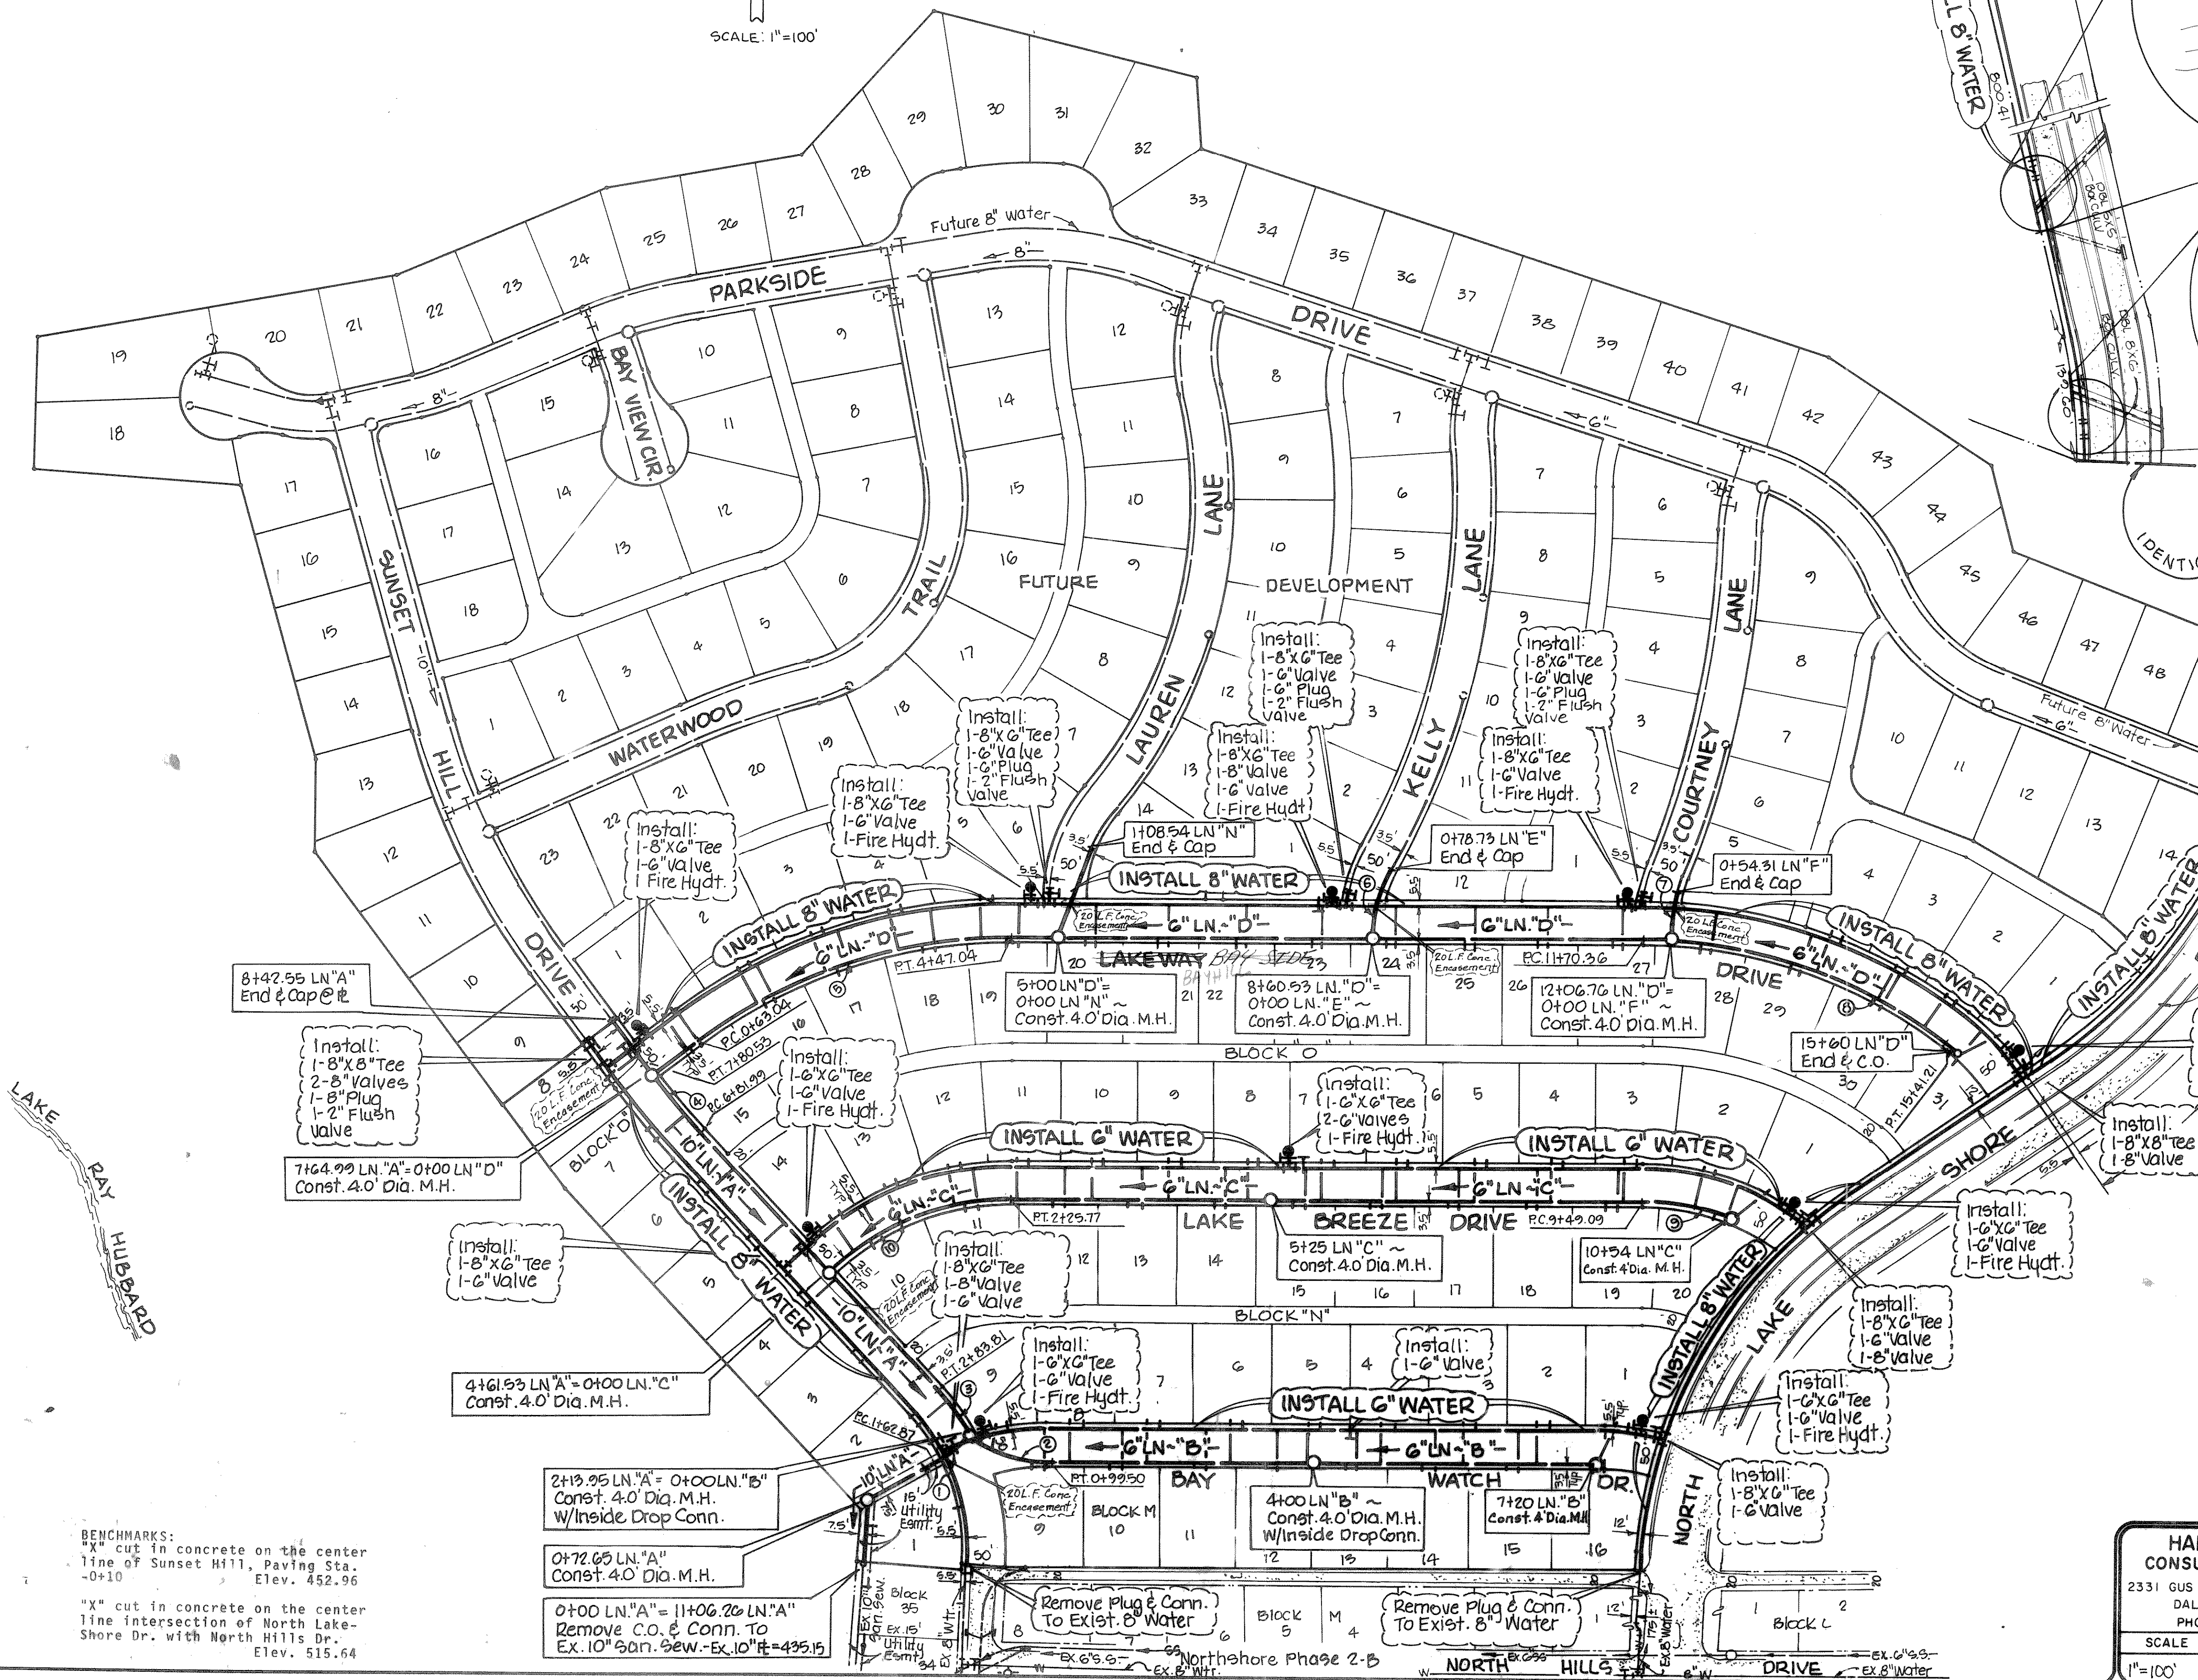
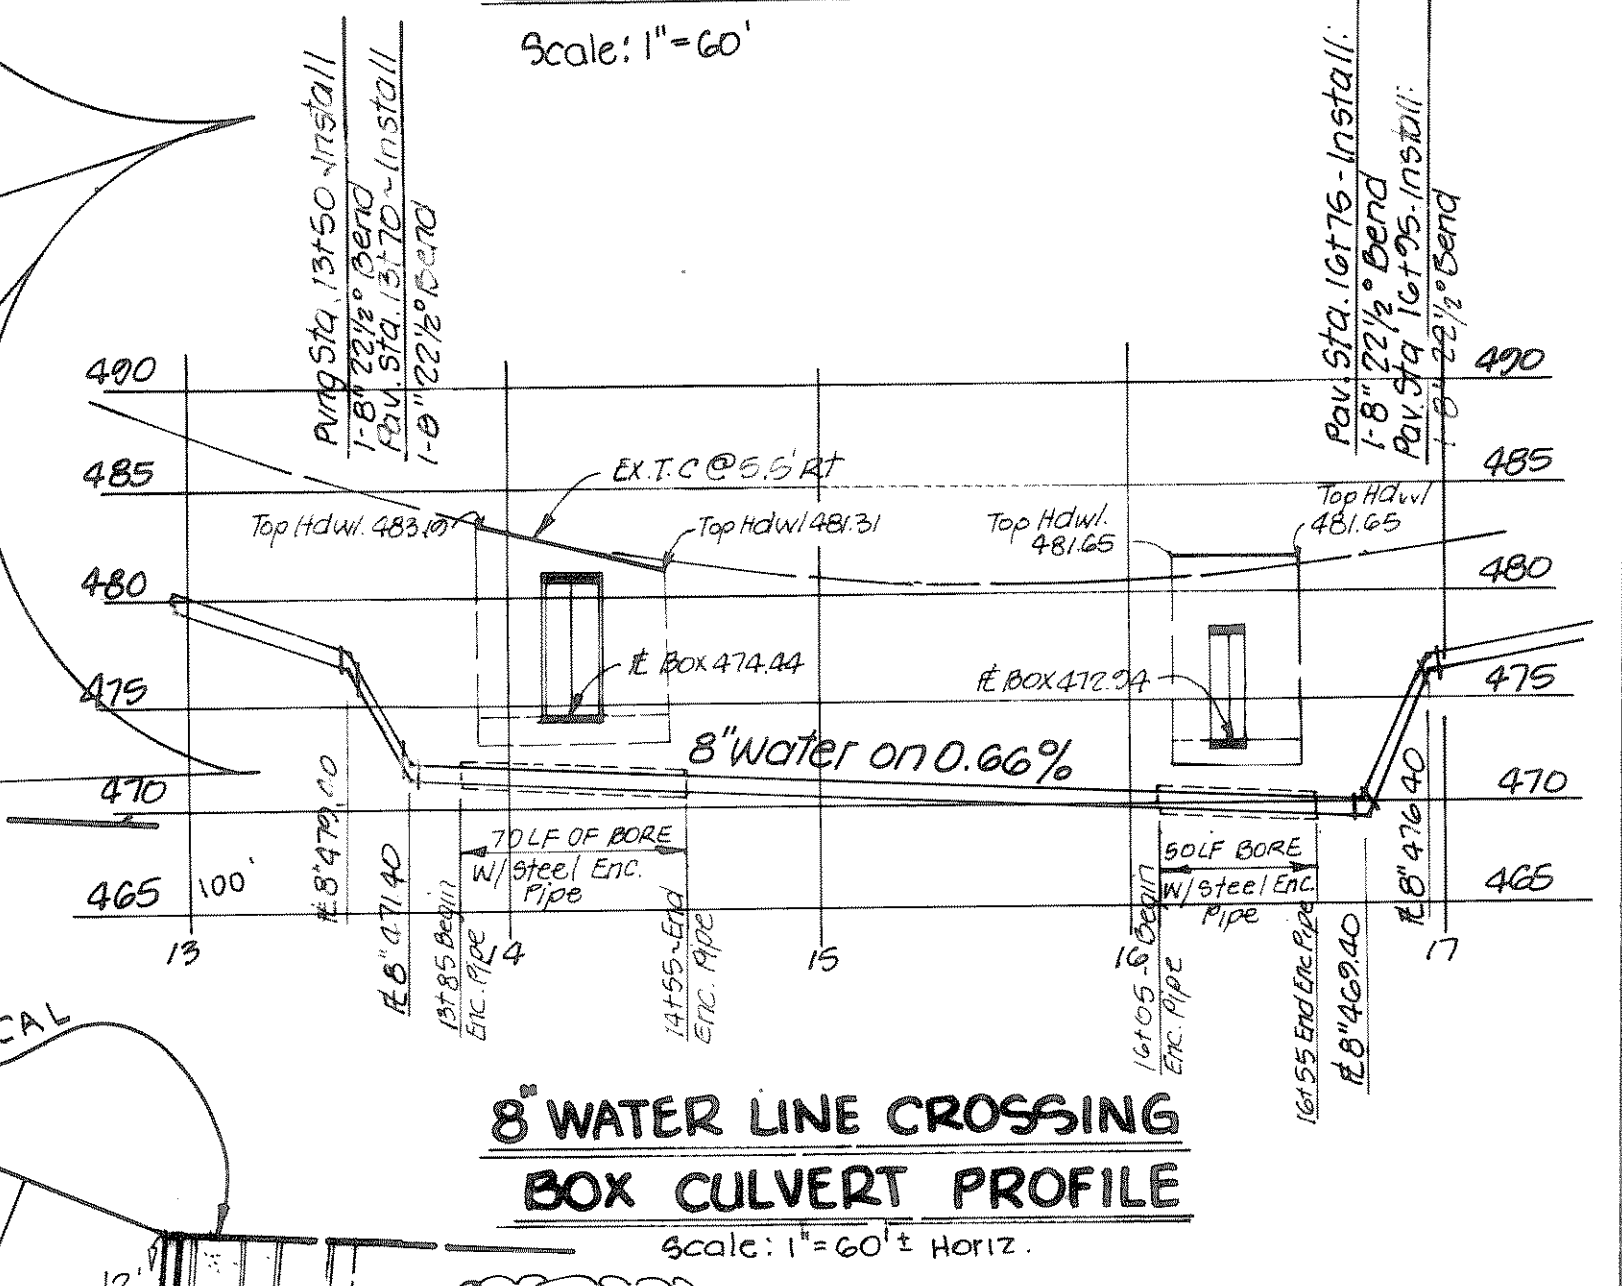


SANITARY SEWER CURVE DATA						
CV. NO.	BEARING	CHORD	DELTA	RADIUS	LENGTH	TAN.
①	N55°52'55"E	51.02'	9°45'20"	300.00'	51.06'	25.60'
②	S71°02'00"E	97.69'	38°00'26"	150.00'	99.50'	51.66'
③	N36°16'59"W	69.70'	1°20'32"	300.00'	69.86'	35.09'
④	N39°55'49"W	98.49'	6°02'59"	933.50'	98.54'	49.32'
⑤	N71°31'43"E	577.41'	36°52'10"	996.74'	564.00'	128.91'
⑥	N14°59'59"E	77.83'	30°04'23"	150.00'	78.73'	40.29'
⑦	N11°55'40"E	54.02'	20°16'13"	153.80'	54.31'	27.44'
⑧	S71°24'57"E	364.36'	37°14'32"	570.55'	370.85'	192.24'
⑨	S75°55'41"E	104.25'	22°13'09"	270.55'	104.91'	53.12'
⑩	N68°10'00"E	220.37'	4°33'36"	296.74'	229.77'	118.67'

SCALE: 1"=100'

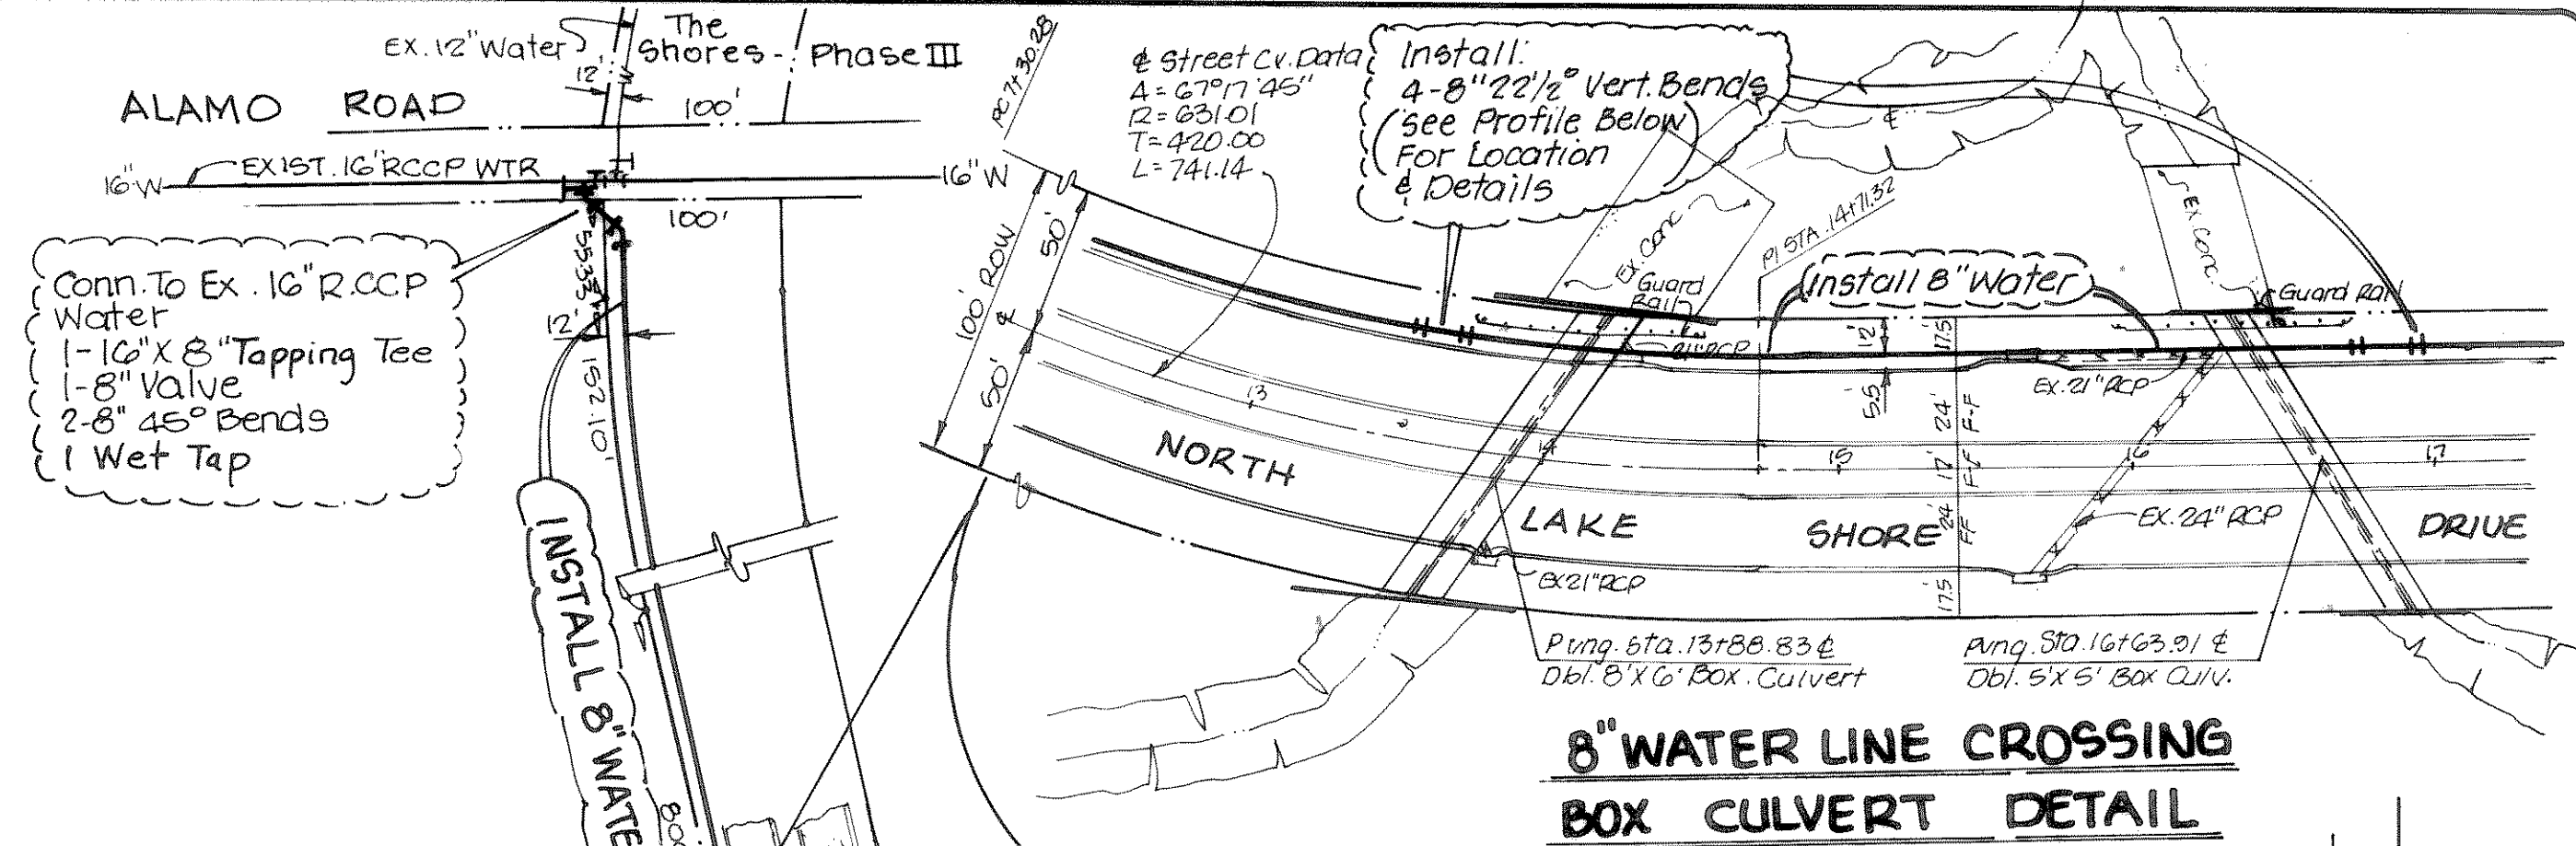

BENCHMARKS:
 "X" cut in concrete on the center line of Sunset Hill, Paving Sta. -0+10 Elev. 452.96
 "X" cut in concrete on the center line intersection of North Lake Shore Dr. with North Hills Dr. Elev. 515.64

HAROLD L. EVANS
 CONSULTING ENGINEER
 2331 GUS THOMASSON RD., SUITE 102
 DALLAS, TEXAS 75228
 PHONE (214) 328-8133

WATER & SANITARY SEWER
HILLCREST SHORES
CITY OF ROCKWALL
ROCKWALL COUNTY, TEXAS