


- NOTES:**
1. Finished grades at front lot lines are 0.25' above top of curb.
  2. P = proposed finished pad grade.
  3. Finished floor elevation shall be 0.8' above proposed pad grade.
  4. All grading shall be in compliance with F.H.A.-H.U.D. data sheet 79-G.
  5. At the time of residence construction, special slope protection shall be provided, if required, to comply with F.H.A.-H.U.D. grading specifications.

**BENCHMARKS:**  
 "X" cut in concrete on the center line of Sunset Hill, Paving Sta. Elev. 452.96 -0+10  
 "X" cut in concrete on the center line intersection of North Lake Shore Dr. with North Hills Dr. Elev. 515.64

<b>HAROLD L. EVANS</b> CONSULTING ENGINEER 2331 GUS THOMASSON RD. SUITE 102 DALLAS, TEXAS 75228 PHONE (214) 328-8133		<b>HILLCREST SHORES</b> A. HANNA SURVEY, ABSTRACT No. 98 CITY OF ROCKWALL, ROCKWALL COUNTY, TEXAS	
SCALE	DATE	JOB NO.	
1" = 40'	8-12-78	154-B-17-93	

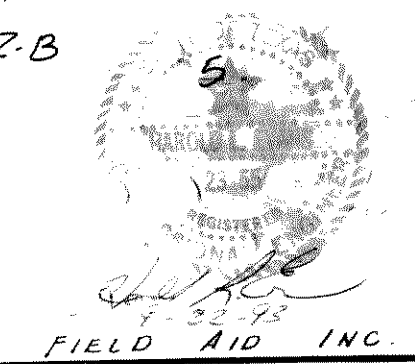

Northshore Phase 2.B  
 Block M

GRADING PLANS