


AS-BUILT

BENCHMARKS:  
 "X" cut in concrete on the center line of Sunset Hill, Paving Sta. -0+10 Elev. 452.96  
 "X" cut in concrete on the center line intersection of North Lake-Shore Dr. with North Hills Drive. Elev. 515.64

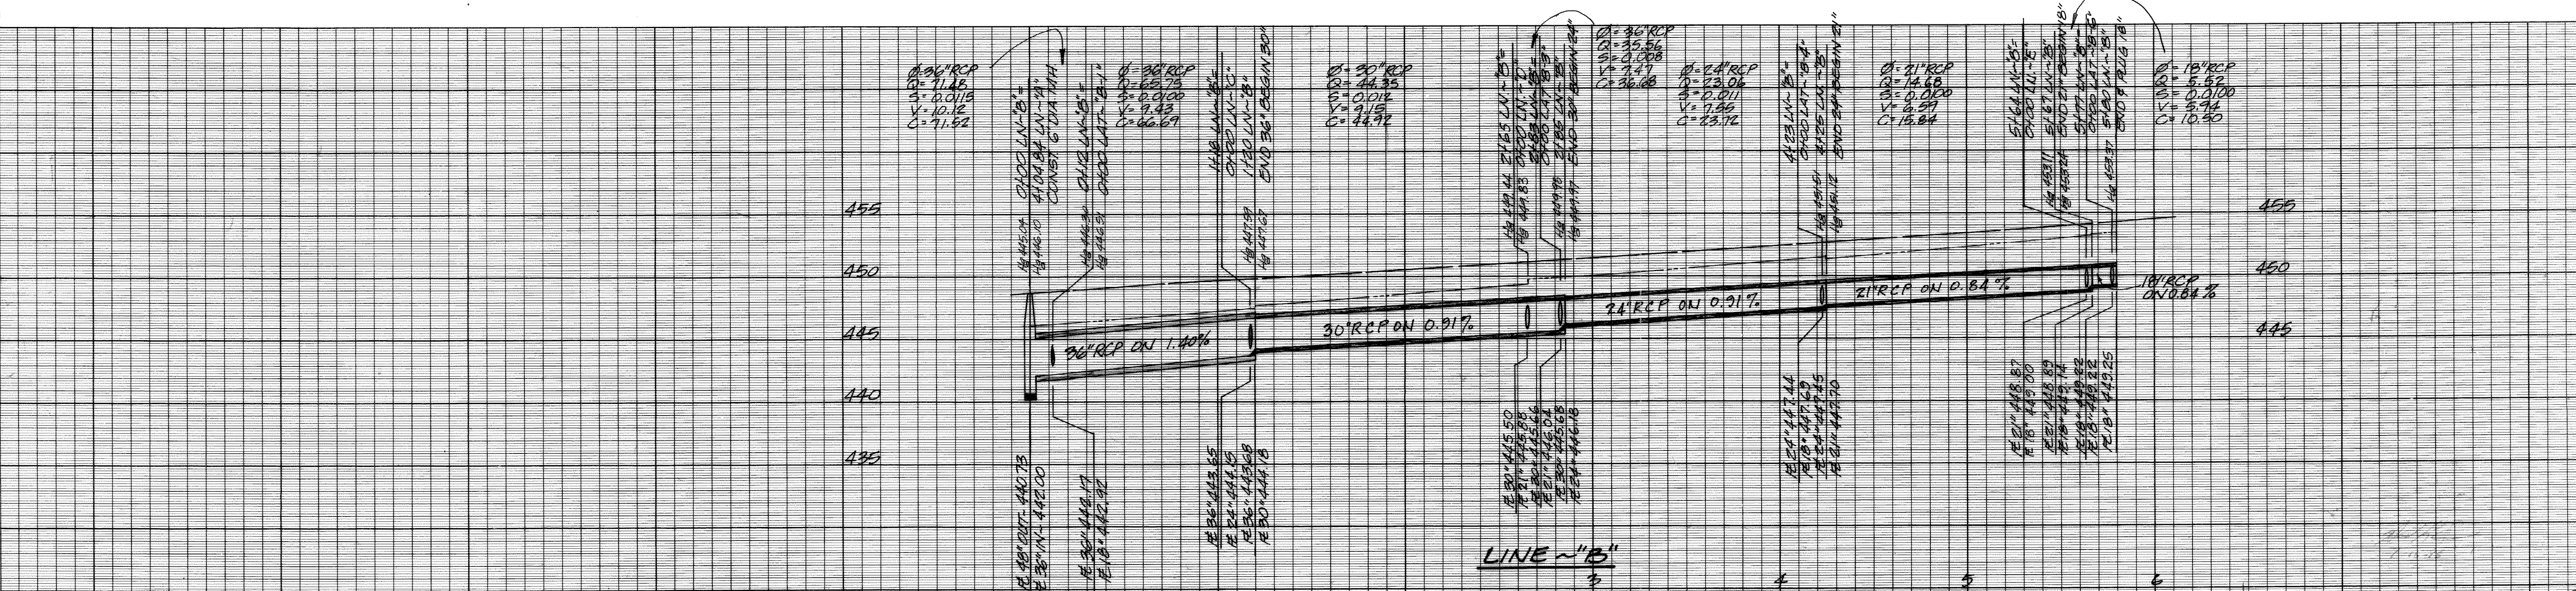

1. Revise Pipe & Values & Inlet Size to 15" Inlet @ Bay Watch Drive & Sunset Hill Dr. 2. Numerous Revisions & Addition of Line "D" Lake Breeze Dr. & Line "E" @ Bay Watch Dr. 3. Revise Grades on Line "B" Storm Sewer & Lat. Nos. on Sunset Hill Dr.	8-25-93 10-11-93 1-10-94	HAROLD L. EVANS & ASSOCIATES Consulting Engineers P. O. Box 28355 2331 Gus Thomasson Road, Suite 102 Dallas, Texas 75228 (214) 328-8133	<b>STORM SEWER PLAN</b> <b>LINE "B" &amp; LAT "B-1" THRU "B-6"</b> <b>HILLCREST SHORES</b> <b>ROCKWALL, ROCKWALL COUNTY, TEXAS</b>	SHEET NO. <b>13</b> <b>18</b>
	REVISION DESCRIPTION DATE SCALE DESIGN DRAWN 1-21-94 1/4"=1'-0" HLE PN			JOB NO. <b>9323</b>