


AS-BUILT

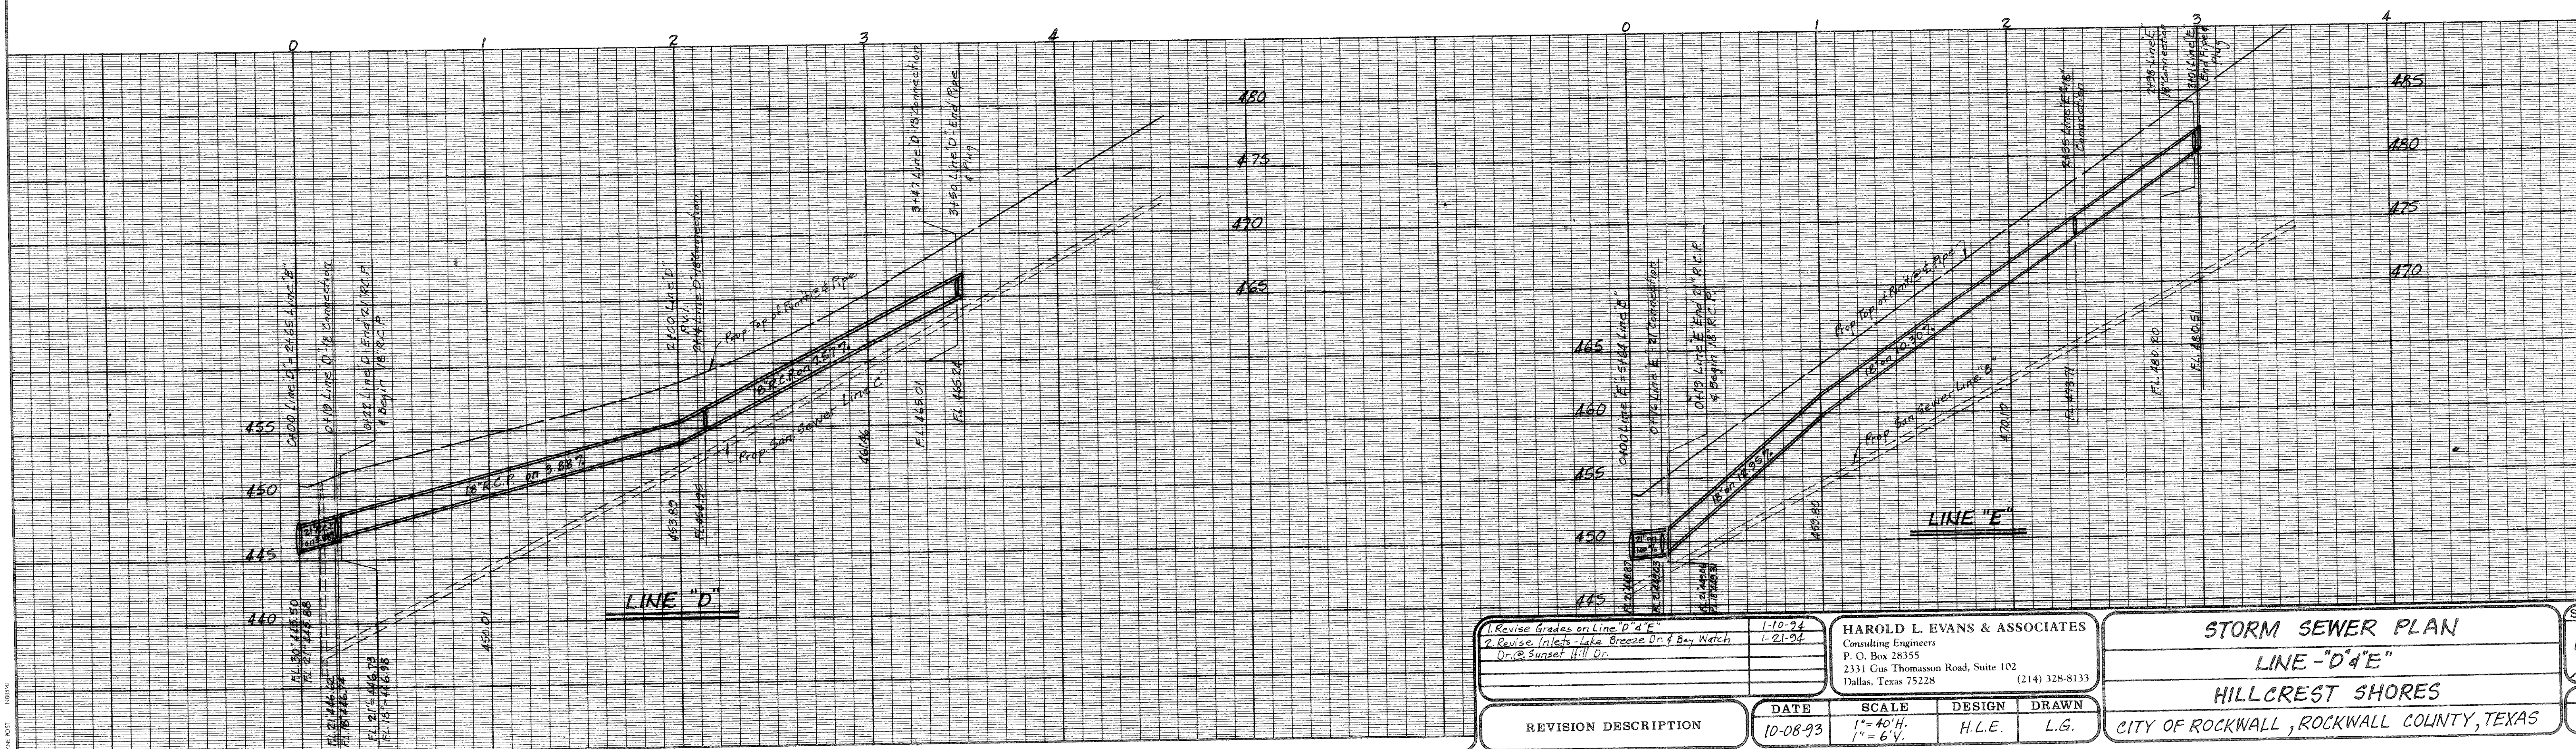

| REVISION DESCRIPTION   | DATE     | SCALE                     | DESIGN | DRAWN |
|--|----------|---------------------------|--------|-------|
| 1. Revise Grades on Line 'D' & 'E'                                 | 1-10-94  |                           |        |       |
| 2. Revise Inlets Lake Breeze Dr. & Bay Watch Dr. @ Sunset Hill Dr. | 1-21-94  |                           |        |       |
|  | 10-08-93 | 1" = 40' H.<br>1" = 6' V. | H.L.E. | L.G.  |

HAROLD L. EVANS & ASSOCIATES  
 Consulting Engineers  
 P. O. Box 28355  
 2331 Gus Thomason Road, Suite 102  
 Dallas, Texas 75228 (214) 328-8133

**STORM SEWER PLAN**  
**LINE "D" & "E"**  
**HILLCREST SHORES**  
 CITY OF ROCKWALL, ROCKWALL COUNTY, TEXAS

SHEET NO.  
**13A**  
**18**  
 JOB NO.  
**9323**