

THE CITY OF ROCKWALL, TEXAS

PAVING, DRAINAGE, WATER AND SANITARY SEWER IMPROVEMENTS

FOR

HILLCREST SHORES PHASE II

SHEET INDEX

1. COVER SHEET
2. FINAL PLAT
3. FINAL PLAT
4. FINAL PLAT

PAVING PLANS

5. TYPICAL SECTION & MISCELLANEOUS DETAILS
6. SUNSET HILL DRIVE PAVING PLAN & PROFILE
STA 7+00 TO 15+31.53
EMERALD BAY DRIVE PAVING PLAN & PROFILE
STA 0+00 TO 2+00
7. EMERALD BAY DRIVE PAVING PLAN & PROFILE
STA 2+00 TO 13+31.60
8. KELLY LANE PAVING PLAN & PROFILE
STA 0+00 TO 8+67.70
9. PARKWOOD PLACE PAVING PLAN & PROFILE
STA 0+00 TO 7+30.64
10. WOODHAVEN CIRCLE PAVING PLAN & PROFILE
STA 0+00 TO 5+72.19
HILLCREST CIRCLE PAVING PLAN & PROFILE
STA 0+00 TO 4+02.27
11. COURTNEY CIRCLE PAVING PLAN & PROFILE
STA 0+00 TO 4+89.97
- 12A. BAY HILL DRIVE MODIFICATIONS PLAN
- 12B. NORTH LAKESHORE DRIVE MODIFICATIONS PLAN
13. ALLEY PROFILES - ALLEYS 'A', 'B' & 'C'
14. ALLEY PROFILES - ALLEYS 'D', 'E' & 'F'

STORM DRAINAGE

15. DRAINAGE AREA MAP
16. DRAINAGE CALCULATIONS
17. STORM DRAIN PLAN & PROFILE SYSTEMS 'A' & 'F'
18. STORM DRAIN PLAN & PROFILE SYSTEMS 'B', 'D' & 'E'
- 18A. STORM DRAIN PLAN & PROFILE SYSTEMS 'B', 'D' & 'E'
19. STORM DRAIN LATERAL PROFILES

WATER & SANITARY SEWER


20. WATER LAYOUT
21. SANITARY SEWER LAYOUT
22. SANITARY SEWER PROFILES LINE 'A' STA 0+00 TO 24+00
23. SANITARY SEWER PROFILES LINE 'A' STA 24+00 TO END
LINES 'B', 'C', 'D' & 'F'
24. SANITARY SEWER PROFILES LINES 'E', 'G', 'H' & 'I'

GRADING, RETAINING WALL & EROSION CONTROL

25. GRADING & EROSION CONTROL PLAN EAST
26. GRADING & EROSION CONTROL PLAN CENTER
27. GRADING & EROSION CONTROL PLAN WEST
28. RETAINING WALL PLAN EAST
29. RETAINING WALL PLAN CENTER
30. RETAINING WALL PLAN WEST
31. STORM WATER POLLUTION PREVENTION PLAN
32. STORM WATER POLLUTION PREVENTION PLAN NOTES
33. STORM WATER POLLUTION PREVENTION DETAILS
34. STORM WATER POLLUTION PREVENTION DETAILS
35. MISCELLANEOUS STORM DRAIN DETAILS
36. EXISTING TREE IMPACTS PLAN


CITY OF ROCKWALL STANDARD CONSTRUCTION DETAILS
HEREIN INCORPORATED HEREIN BY REFERENCE

PREPARED BY:
WIA WIER & ASSOCIATES, INC.
ENGINEERS SURVEYORS LAND PLANNERS
4300 BELLEVUE PLACE SUITE 130 ARLINGTON, TEXAS 76018 METRO (817)467-7700
3908 SOUTH FREEWAY FORT WORTH, TEXAS 76110 (817)926-0212

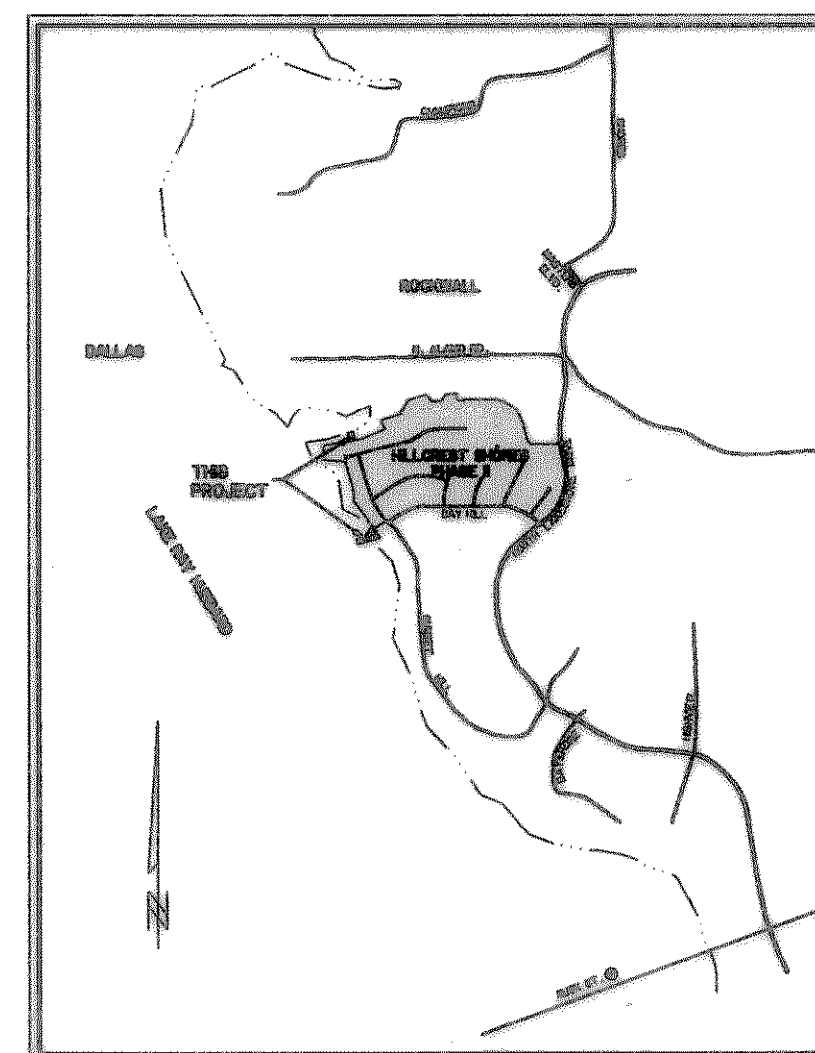

LOCATION MAP
N.T.S.

OWNER - DEVELOPER:
HILLCREST SHORES, LTD.
14755 PRESTON ROAD
SUITE 830
DALLAS, TEXAS 75240
(214) 392-3800

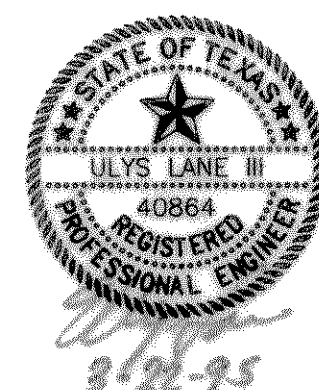

3/22-95