


PREPARED BY:  
**WIA WIER & ASSOCIATES, INC.**  
ENGINEERS SURVEYORS LAND PLANNERS  
430 BELTWAY PLACE SUITE 130 ARLINGTON, TEXAS 76018 METRO (817)467-7700  
3808 SOUTH FREEWAY FORT WORTH, TEXAS 76110 (817)925-0212


**HILLCREST SHORES  
PHASE II  
CITY OF ROCKWALL,  
ROCKWALL COUNTY, TEXAS**

**KELLY LANE  
PLAN AND PROFILE  
STA 0+00 TO STA 8+67.70**

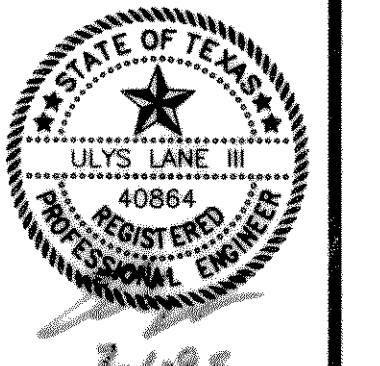

7-198  
COPYRIGHT ©  
WIER & ASSOCIATES, INC.  
LAST SHEET EDIT  
DATE 03-01-95  
FILE PAVE3  
WA# 93065

**SHEET NO. 8**

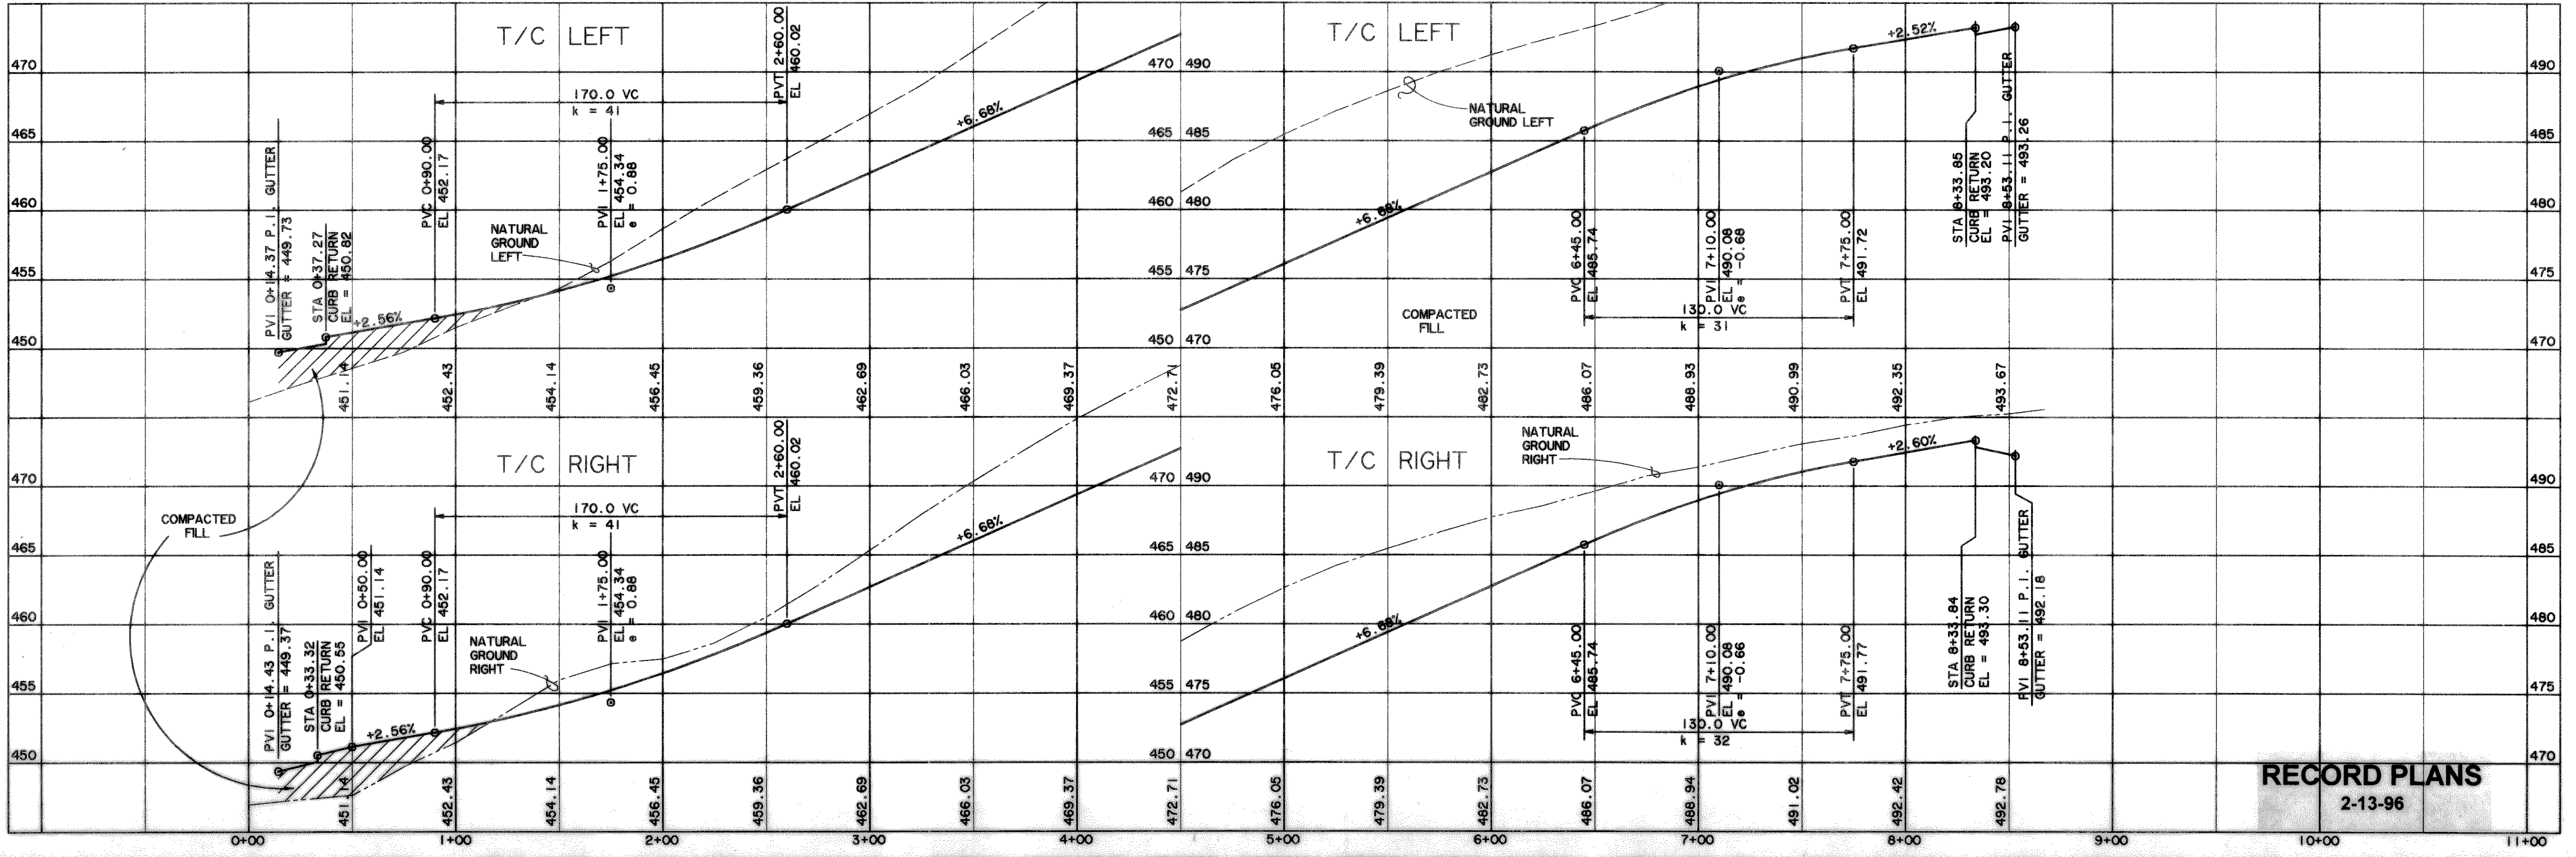

**RECORD PLANS**  
2-13-96