


PREPARED BY:
VIA WIER & ASSOCIATES, INC.
ENGINEERS SURVEYORS LAND PLANNERS
4300 BELLEVUE PLACE, SUITE 130 ARLINGTON, TEXAS 76018 (817) 467-7700
3908 SOUTH FREEMAN FORT WORTH, TEXAS 76110 (817) 926-0212

**HILLCREST SHORES
PHASE II
CITY OF ROCKWALL,
ROCKWALL COUNTY, TEXAS**

**PLAN AND PROFILE
WOODHAVEN CIRCLE
STA 0+00 TO STA 5+72.19
HILLCREST CIRCLE
STA 0+00 TO STA 4+02.27**

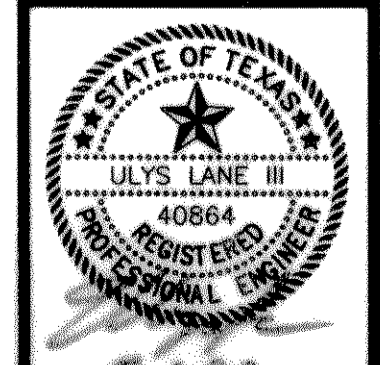

REGISTERED PROFESSIONAL ENGINEER
ULYS LANE III
40864
STATE OF TEXAS
EXPIRES 12/31/03
COPYRIGHT ©
WIER & ASSOCIATES, INC.
LAST SHEET EDIT
DATE 03-01-95
FILE PAVES
WA# 93065
SHEET NO. 10

RECORD PLANS
2-13-96