



- NOTES:**
1. ALL EXISTING WATER VALVES, FIRE HYDRANTS AND SANITARY SEWER MANHOLES ARE TO REMAIN IN PLACE UNLESS OTHERWISE NOTED.
 2. TRENCHING FOR CONNECTIONS TO EXISTING UTILITIES/STORM DRAINS SHALL BE BACKFILLED WITH NATIVE MATERIAL MECHANICALLY COMPACTED IN MAXIMUM 10" LOOSE LIFTS TO A MINIMUM OF 95% PROCTOR DENSITY WITHIN 3 (THREE) PERCENT OF OPTIMUM MOISTURE CONTENT.

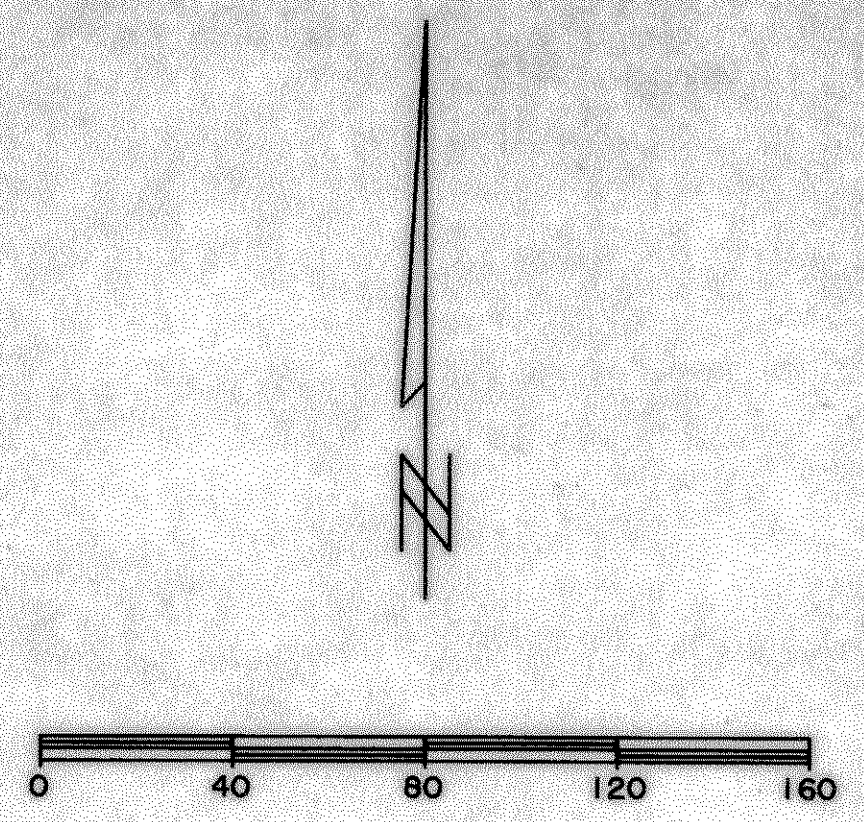

PREPARED BY:
WIA WIER & ASSOCIATES, INC.
 ENGINEERS SURVEYORS LAND PLANNERS
 430 BELTWAY PLACE SUITE 130 ARLINGTON, TEXAS 76010 METRO (817)467-7700
 3008 SOUTH FREEMAN FORT WORTH, TEXAS 76110 (817)926-0312

**HILLCREST SHORES
 PHASE II
 CITY OF ROCKWALL,
 ROCKWALL COUNTY, TEXAS**

**BAY HILL DRIVE
 MODIFICATIONS PLAN**

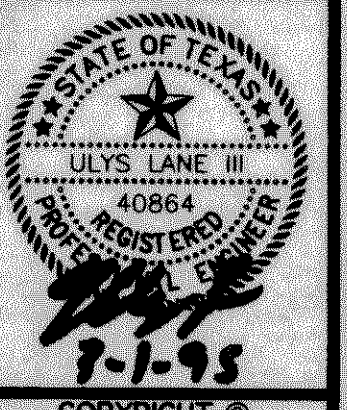

COPYRIGHT ©
 WIER & ASSOCIATES, INC.
 LAST SHEET EDIT
 DATE 02-27-96
 FILE LAKERAN
 WA# 93065

RECORD PLANS
 2-13-96

**SHEET NO.
 12A**