

PHASE I & II  
INSTALL 25 L.F.  
REINFORCED SILT FENCE  
PRIOR TO GRADING  
OPERATIONS

GULLY REPAIR BY UTILITY CONTRACTOR  
BACKFILL SLOPE AND PIPE OUTLET AT  
MAXIMUM 2:1 SLOPE. LIVE FACE WITH  
6" TO 12" DIAMETER HARD LIMESTONE  
ROCK RUBBLE. REFER TO S.D. PROPER  
RIPRAP AT OUTLET.

GULLY REPAIR BY GRADING CONTRACTOR  
FILL GULLY @ MAXIMUM 2:1 SLOPE FROM  
BASE OF CREEK TOE OF SLOPE. LIVE  
FACE WITH 6" TO 12" DIAMETER  
HARD LIMESTONE ROCK RUBBLE.

PHASE I  
PROVIDE 14 L.F.  
ROCK BERM 12"  
HIGH "U" SHAPED  
AND 80 L.F.  
SILT FENCE

REFER TO S.D. PROFILE  
FOR RIPRAP AT  
CULVERT OUTLET

PHASE I  
INSTALL 10 L.F.  
SILT FENCE

REFER TO S.D. PROFILE  
FOR RIPRAP AT  
CULVERT  
OUTLET

PHASE I  
PROVIDE 14 L.F.  
12" ROCK BERM 12"  
HIGH "U" SHAPED 40'  
L.F. SILT FENCE

PHASE I  
INSTALL 40 L.F.  
SILT FENCE

PHASE I, II, & III  
INSTALL SILT FENCE  
3' BACK OF CURB  
REMOVE WHEN LOTS  
HAVE BEEN RE-VEGETATED

PHASE I, II, & III  
REPAIR & MAINTAIN  
EXIST. SILT FENCE  
3' FT. B/C


PHASE I  
GRADING CONSTRUCTION APPROX.  
LOCATION TEMPORARY  
CONSTRUCTION ACCESS.  
COORDINATE WITH CITY ENGINEER  
TO LOCATE

PHASE III  
AFTER PAVEMENT INSTALL  
8" HIGH ROCK BERM BY 6'  
LONG

PHASE I, II, & III  
REPAIR & MAINTAIN  
EXIST. SILT FENCE  
3' FT. B/C

PHASE I, II, & III  
INSTALL 20' SILT FENCE  
AFTER PAVEMENT INSTALLED  
8" HIGH ROCK BERM BY 6'  
LONG @ GUTTER

\* LOTS WITH PADS AND/OR  
WALLS REVISED 1-1-96

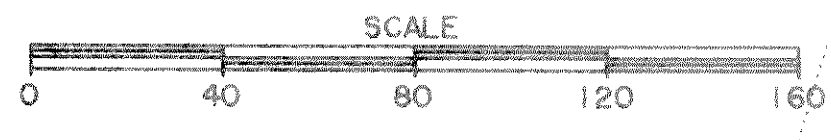


MATCH LINE SEE SHEET 26

**RECORD PLANS**  
2-13-96

PREPARED BY:  
**VIA WIER & ASSOCIATES, INC.**  
ENGINEERS SURVEYORS LAND PLANNERS  
430 BELMONT PLACE SUITE 130 ARLINGTON TEXAS 76010 METRO (817) 467-7700  
3908 SOUTH FREEWAY FORT WORTH, TEXAS 76110 (817) 926-0212

**HILLCREST SHORES  
PHASE II  
CITY OF ROCKWALL,  
ROCKWALL COUNTY, TEXAS**

**GRADING & EROSION  
CONTROL PLAN  
EAST**

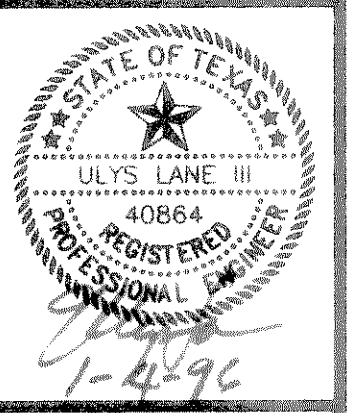

COPYRIGHT ©  
WIER & ASSOCIATES, INC.  
LAST SHEET EDIT  
DATE 01-04-96  
FILE GRADE 3  
WA# 93065

**SHEET NO.**  
25