

* LOTS WITH PADS AND/OR WALLS REVISED 1-1-96

LEGEND

----- PROPOSED GRADING RETAINING WALL


- * BENCH MARKS ***
- BOX CUT IN TOP OF CURB AT CURB LAYDOWN FOR HANDICAP RAMP AT NORTHEAST CORNER OF INTERSECTION NORTH LAKESHORE DRIVE & BAY HILL DRIVE. ELEV. 523.40
 - BOX CUT IN WEST END CURB INLET TOP AT NORTHEAST CORNER OF INTERSECTION OF BAY HILL DRIVE AND SUNSET HILL DRIVE. ELEV. 449.74

INSTALL 6" WIDE STEPS FROM ROCK WALL MATERIAL (11" WIDE x 7" HIGH STEPS).

PREPARED BY:
WIA WIER & ASSOCIATES, INC.
 ENGINEERS SURVEYORS LAND PLANNERS
 4300 BELWAY PLACE SUITE 130 ARLINGTON, TEXAS 76010 (817)467-7700
 3908 SOUTH FREEMAN FORT WORTH, TEXAS 76110 (817)926-0212

**HILLCREST SHORES
 PHASE II
 CITY OF ROCKWALL,
 ROCKWALL COUNTY, TEXAS**

**RETAINING WALL
 PLAN WEST**

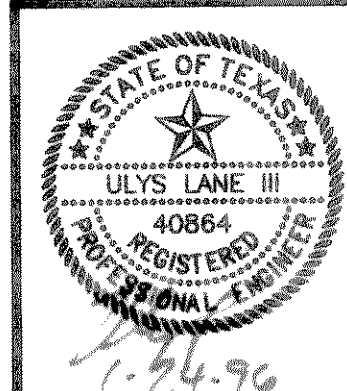

COPYRIGHT ©
 WIER & ASSOCIATES, INC.
 LAST SHEET EDIT
 DATE 01-24-96
 FILE C:\93065\T
 WA# 93065