



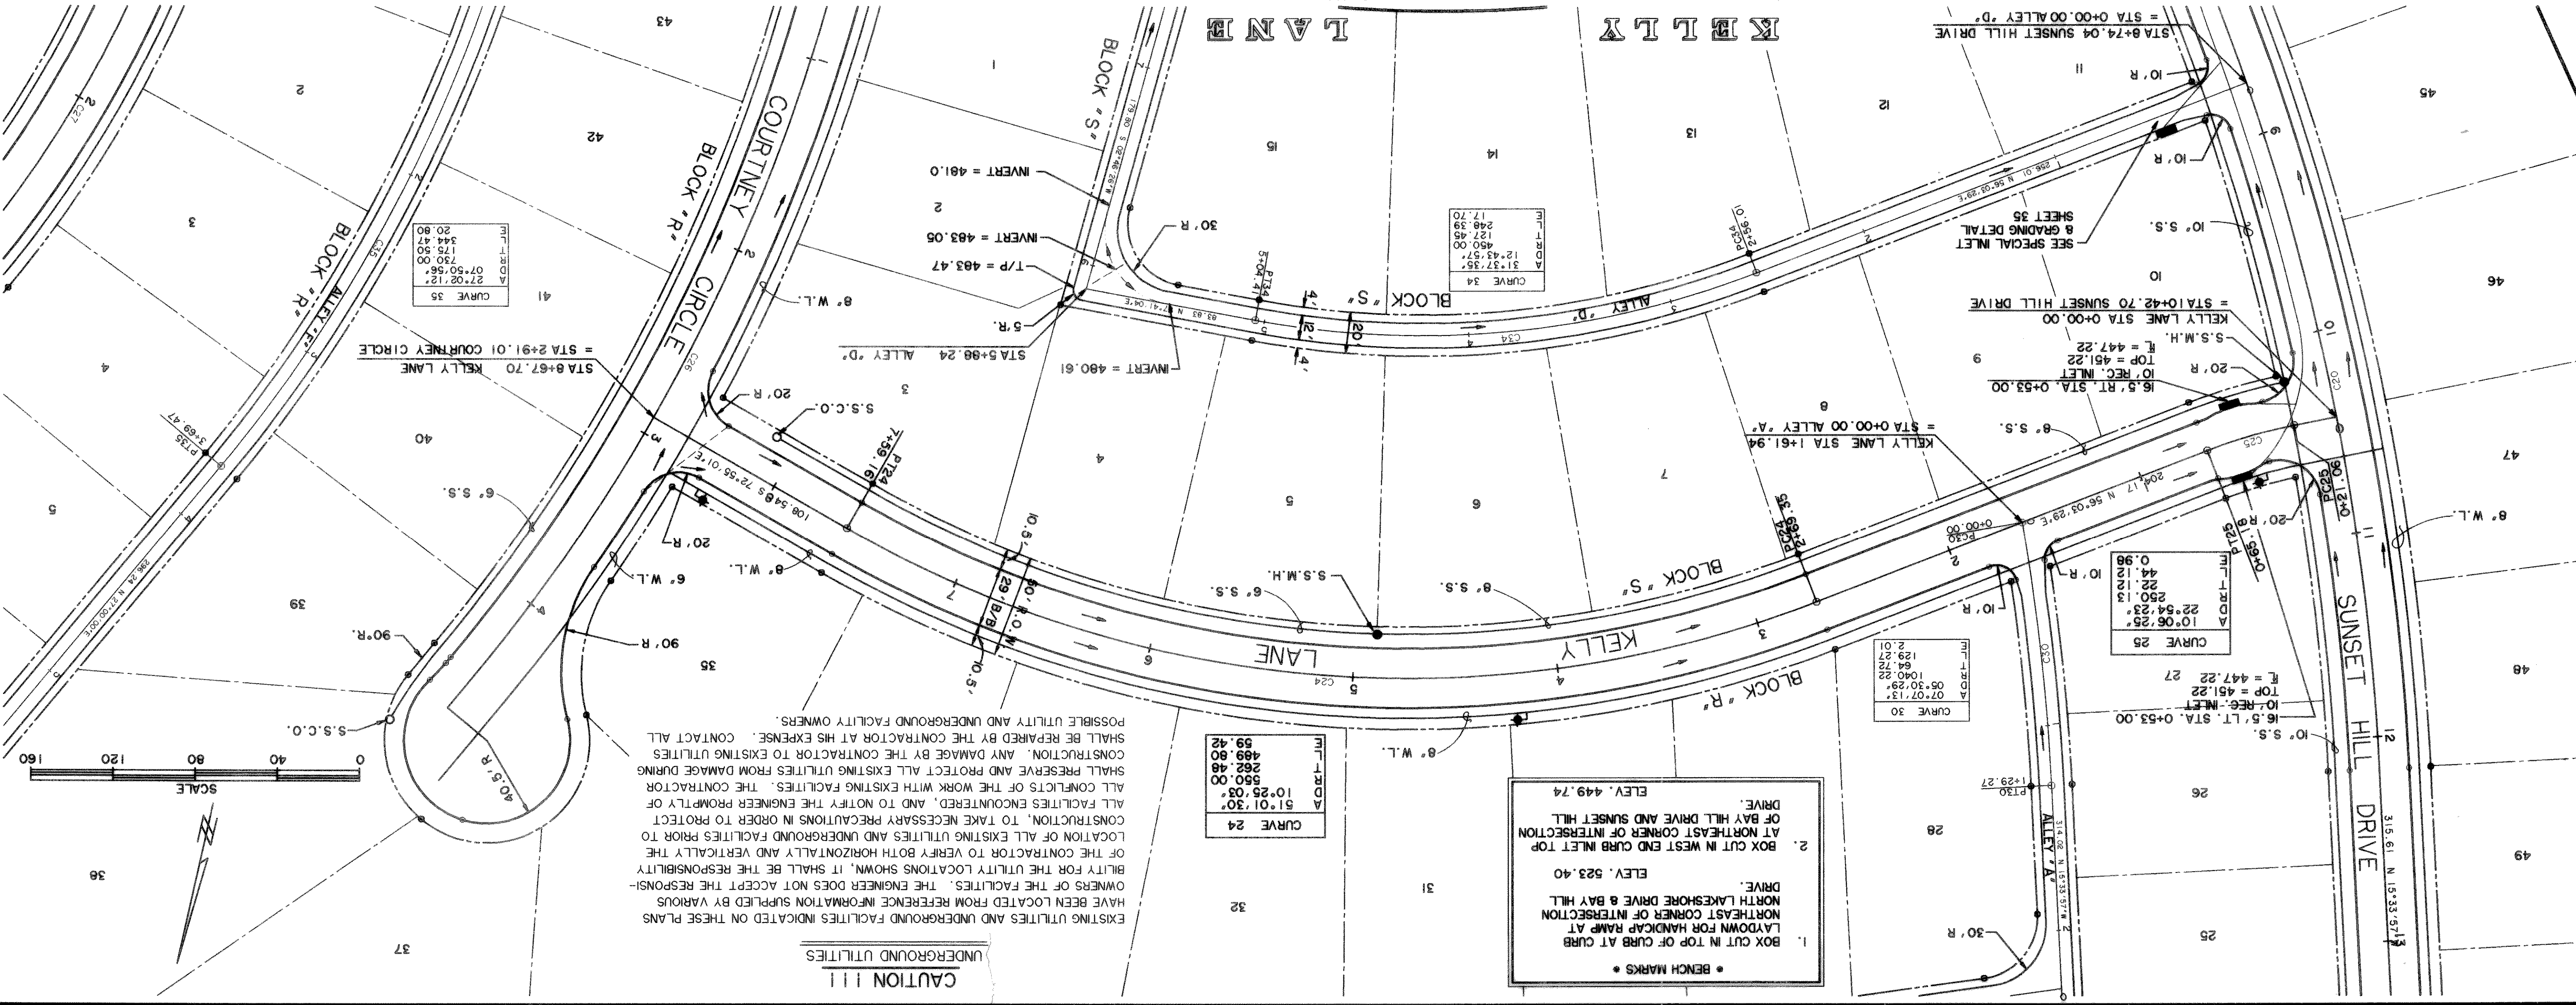

**KELLY LANE
 PLAN AND PROFILE
 STA 0+00 TO STA 8+67.70**

**HILLCREST SHORES
 PHASE II
 CITY OF ROCKWALL,
 ROCKWALL COUNTY, TEXAS**

PREPARED BY:
WIA WIER & ASSOCIATES, INC.
 ENGINEERS SURVEYORS LAND PLANNERS
 4300 BELTWAY PLACE SUITE 130 AMARILLO, TEXAS 79818 MEMPHIS (901) 942-7700
 3000 SOUTH FREEMAN FORT WORTH, TEXAS 76110 (817) 928-0212

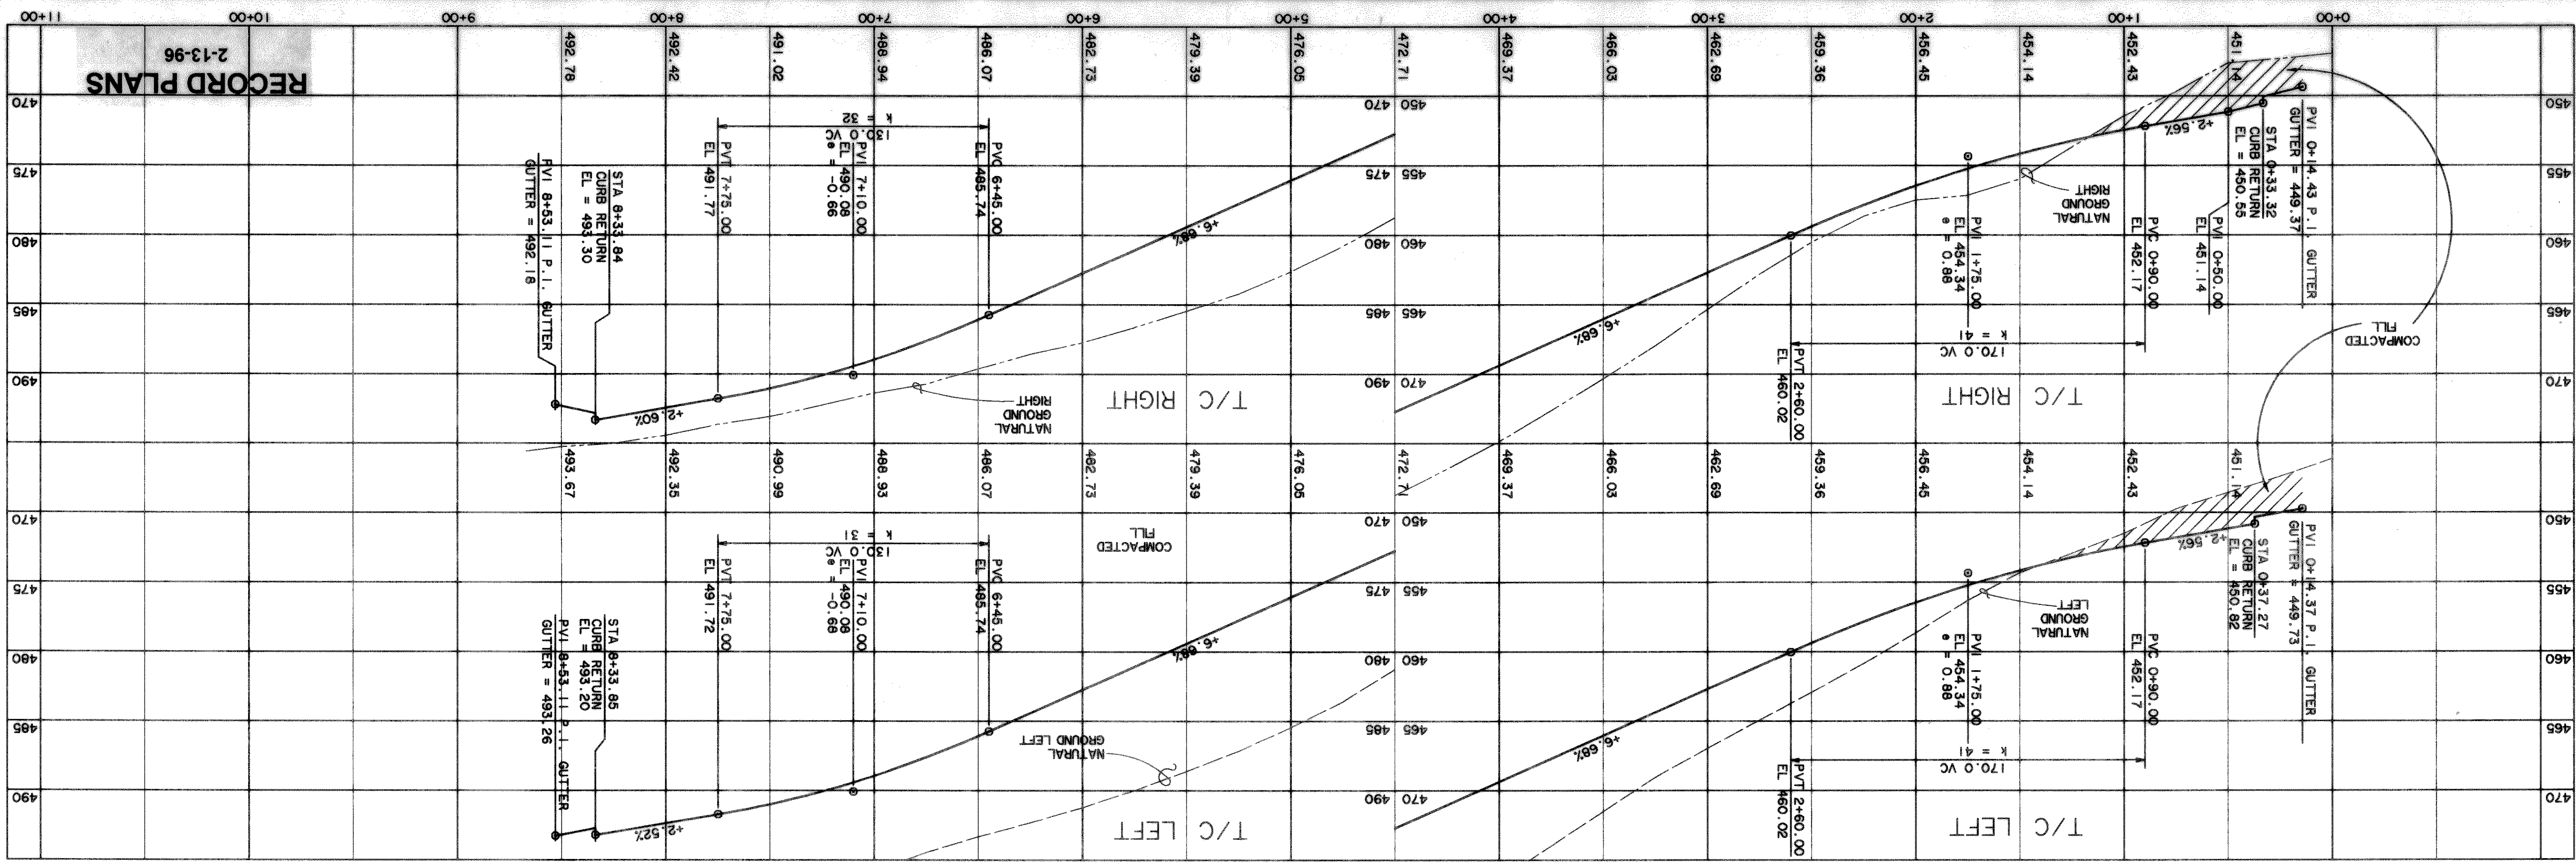

CAUTION !!!
 UNDERGROUND UTILITIES

EXISTING UTILITIES AND UNDERGROUND FACILITIES INDICATED ON THESE PLANS HAVE BEEN LOCATED FROM REFERENCE INFORMATION SUPPLIED BY VARIOUS OWNERS OF THE FACILITIES. THE ENGINEER DOES NOT ACCEPT THE RESPONSIBILITY FOR THE UTILITY LOCATIONS SHOWN. IT SHALL BE THE RESPONSIBILITY OF THE CONTRACTOR TO VERIFY BOTH HORIZONTALLY AND VERTICALLY THE LOCATION OF ALL EXISTING UTILITIES AND UNDERGROUND FACILITIES PRIOR TO CONSTRUCTION, TO TAKE NECESSARY PRECAUTIONS IN ORDER TO PROTECT ALL FACILITIES ENCOUNTERED, AND TO NOTIFY THE ENGINEER PROMPTLY OF ALL CONFLICTS OF THE WORK WITH EXISTING UTILITIES. THE CONTRACTOR SHALL PRESERVE AND PROTECT ALL EXISTING UTILITIES FROM DAMAGE DURING CONSTRUCTION. ANY DAMAGE BY THE CONTRACTOR TO EXISTING UTILITIES SHALL BE REPAIRED BY THE CONTRACTOR AT HIS EXPENSE. CONTACT ALL POSSIBLE UTILITY AND UNDERGROUND FACILITY OWNERS.

TABLE 24

STATION	ELEVATION
51+01.30	489.80
10+25.03	489.48
50.00	489.80
59.42	489.80

TABLE 34

STATION	ELEVATION
31+37.36	450.00
12+43.57	450.00
450.00	450.00
17.70	450.00

TABLE 30

STATION	ELEVATION
07+07.13	447.22
08+50.29	447.22
1040.25	447.22
129.27	447.22
2.01	447.22

TABLE 25

STATION	ELEVATION
10+06.25	451.22
22+54.23	451.22
250.13	451.22
44.22	451.22
0.96	451.22

TABLE 35

STATION	ELEVATION
27+02.12	493.20
07+50.56	493.20
175.50	493.20
344.47	493.20
20.80	493.20