

STATE HIGHWAY 66

LAKE SHORE DRIVE

LOT 1  
BLOCK A


31  
BLOCK J

STONEBRIDGE MEADOWS PHASE FIVE  
CAB. A. SLIDE 388

STONEBRIDGE MEADOWS PHASE FIVE  
CAB. A. SLIDE 388

BLOCK A

CURVE	RADIUS	LENGTH	TANGENT	CHORD	BEARING	DELTA
C1	1427.00'	263.86'	132.31'	263.49'	S15°38'40" E	103°5'40"
C2	3949.71'	208.61'	104.33'	208.58'	N77°29'50" E	03°01'34"
C3	18.00'	25.96'	15.89'	23.77'	S48°07'01" E	82°37'55"
C4	27.00'	35.96'	21.21'	33.36'	S33°20'53" W	76°17'53"
C5	22.00'	35.90'	23.38'	32.04'	N61°45'39" W	93°29'01"
C6	14.50'	20.91'	12.75'	19.15'	S48°07'01" E	82°37'55"
C7	14.50'	7.83'	4.01'	7.73'	S20°16'06" E	30°58'08"
C8	30.55'	8.05'	4.05'	8.03'	N85°00'20" E	15°07'23"

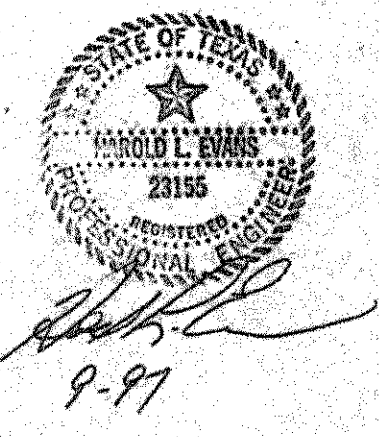

<p>HAROLD L. EVANS CONSULTING ENGINEER 2331 CUS THOMASSON ROAD, SUITE 102 DALLAS, TEXAS 75228, (214) 328-8133</p>		<p>DIMENSION CONTROL PLAN HOLLEY ADDITION B.F. BOYDSTUN SURVEY, ABST. NO. 14 CITY OF ROCKWALL</p>		<p>SHEET NO. 3</p>	
<p>REVISION DESCRIPTION</p>	<p>DATE 8/26/97</p>	<p>SCALE 1" = 20'</p>	<p>DESIGN H.L.E.</p>	<p>DRAWN</p>	<p>JOB NO. 9755</p>