




STATE HIGHWAY 66
APPROX. LIMITS 100 YEAR FLOOD

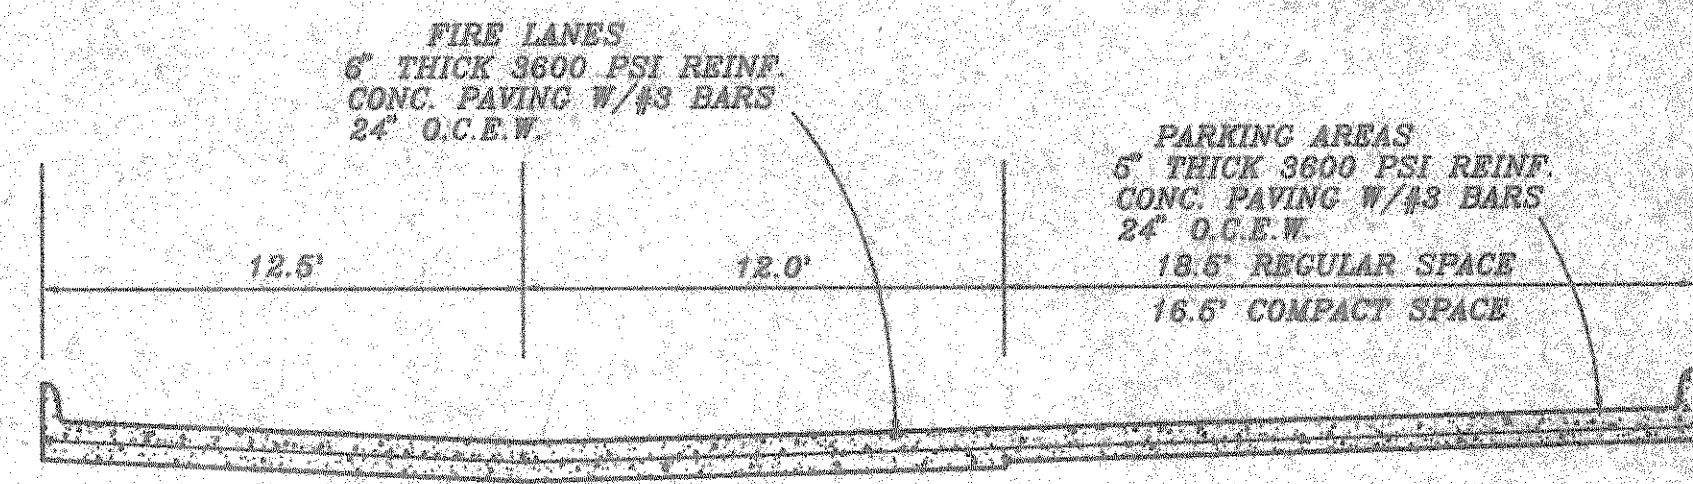


TYPICAL PAVING DETAIL

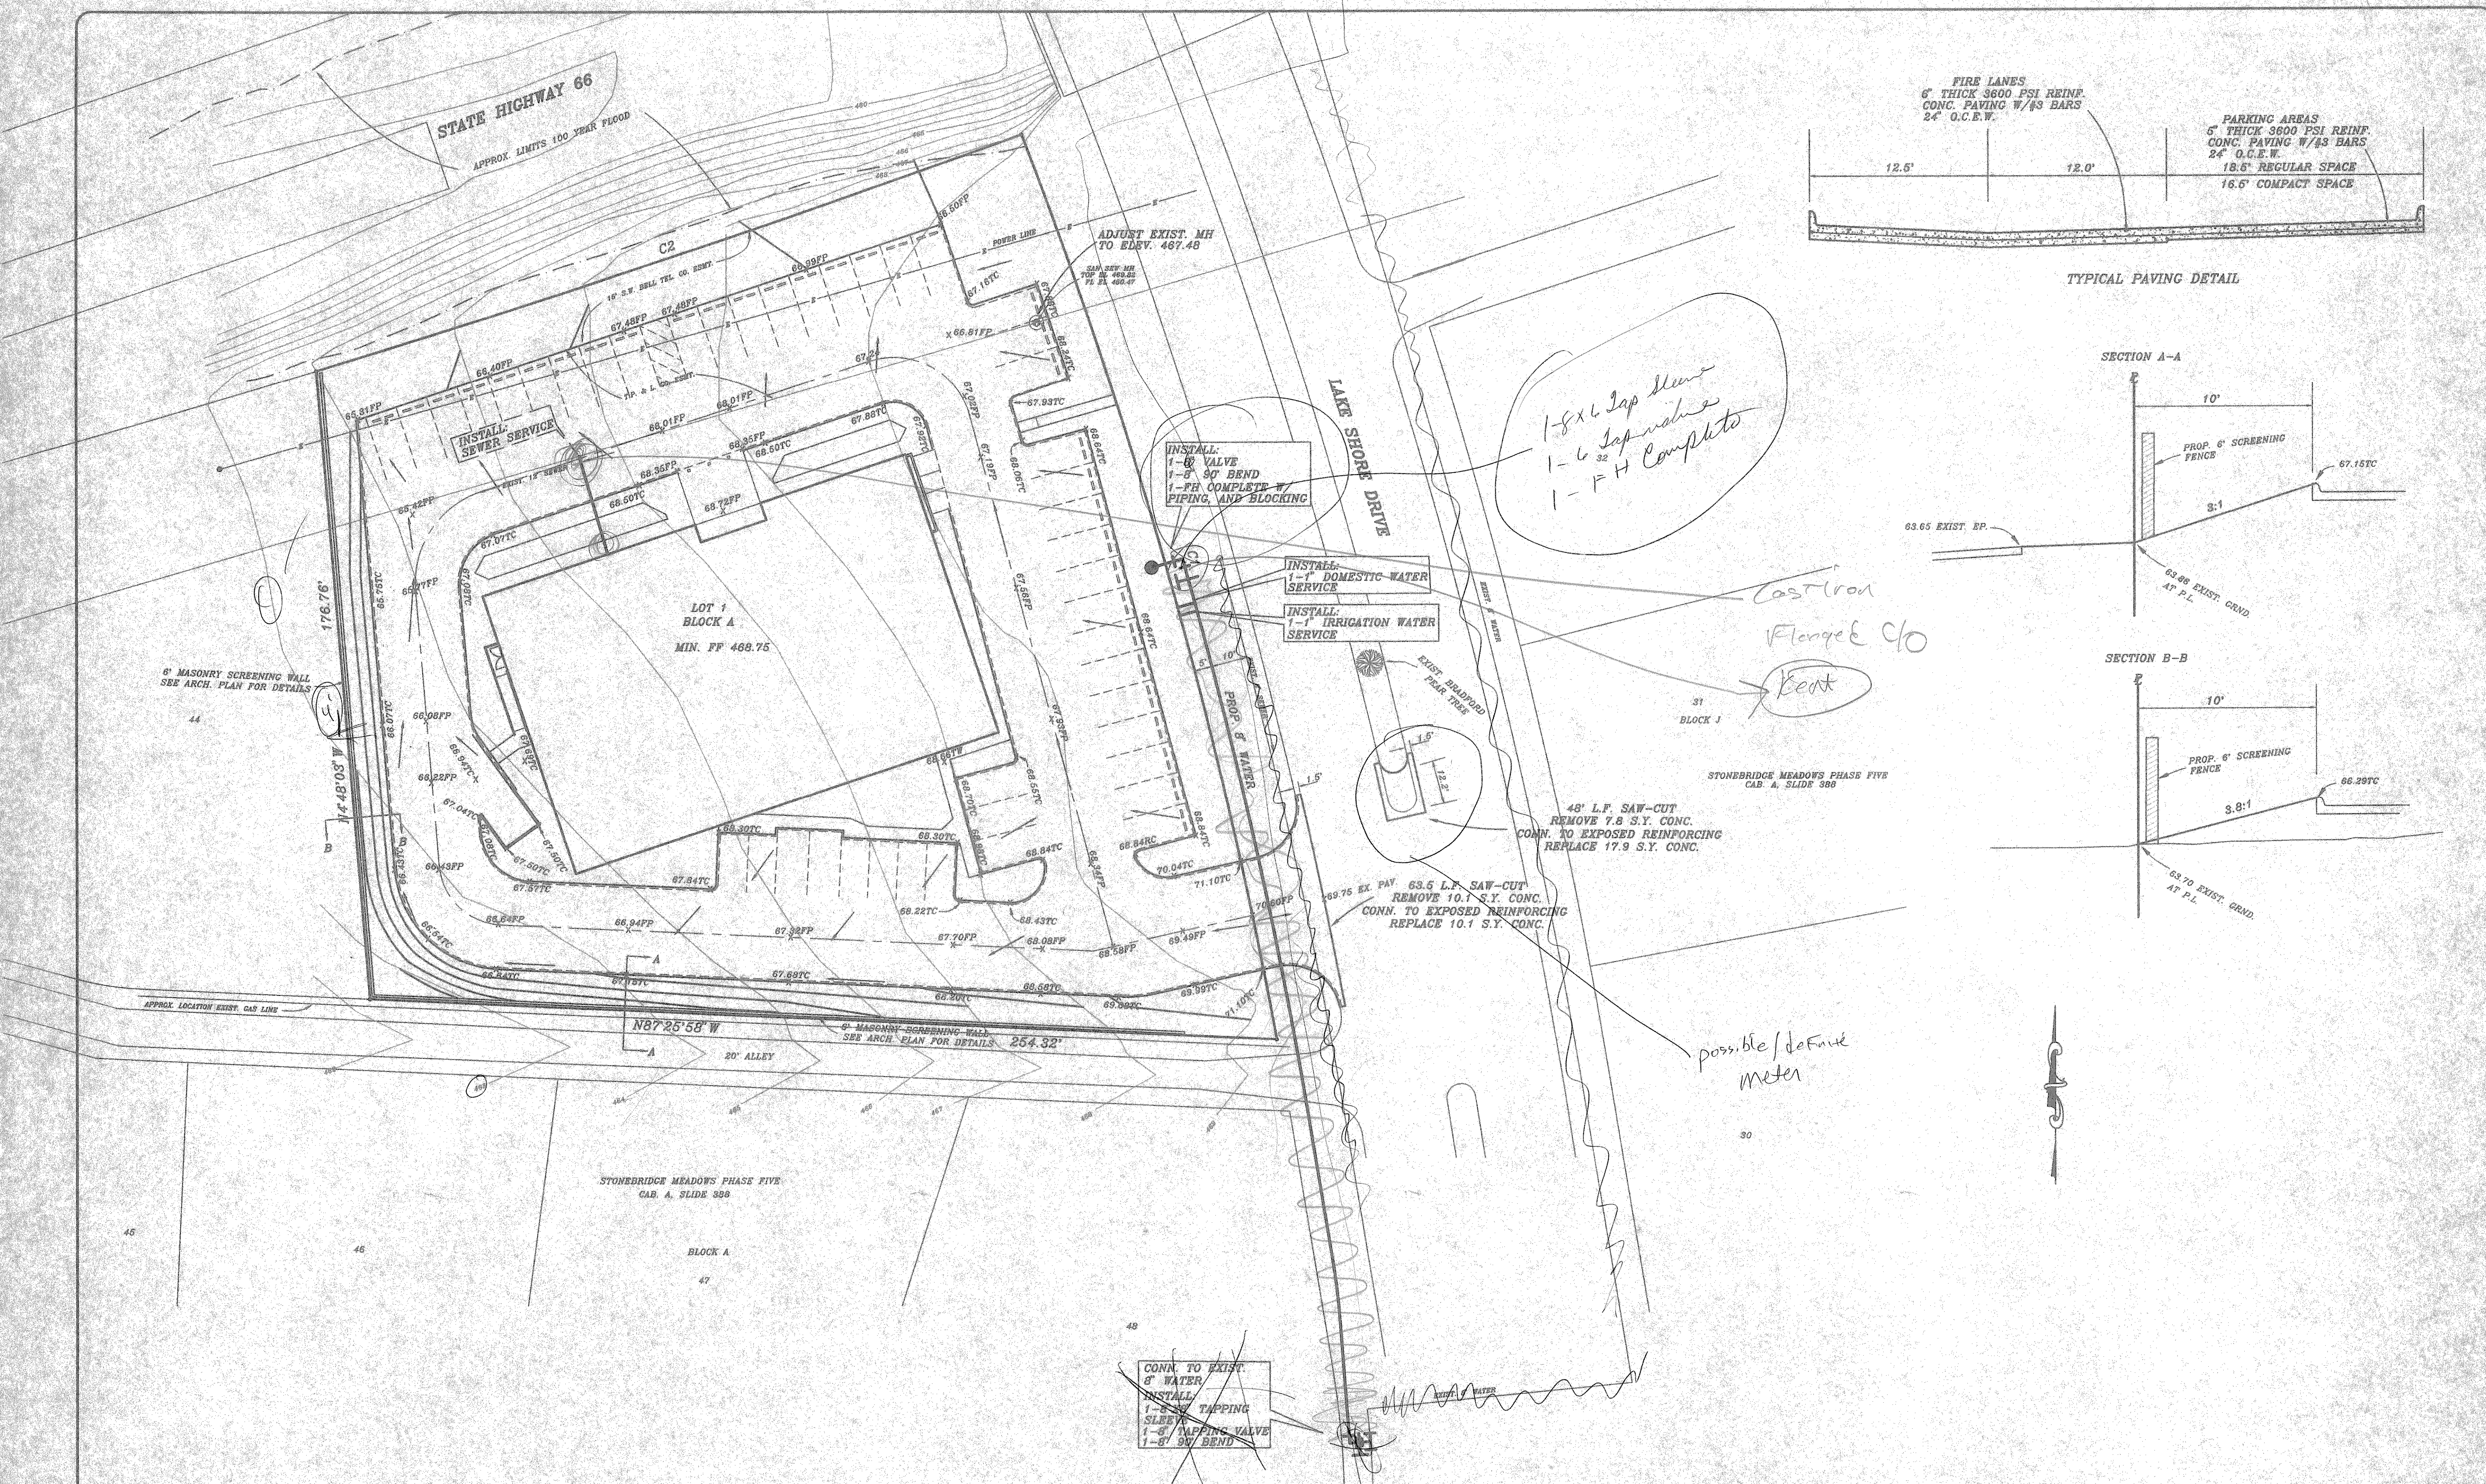

SECTION A-A

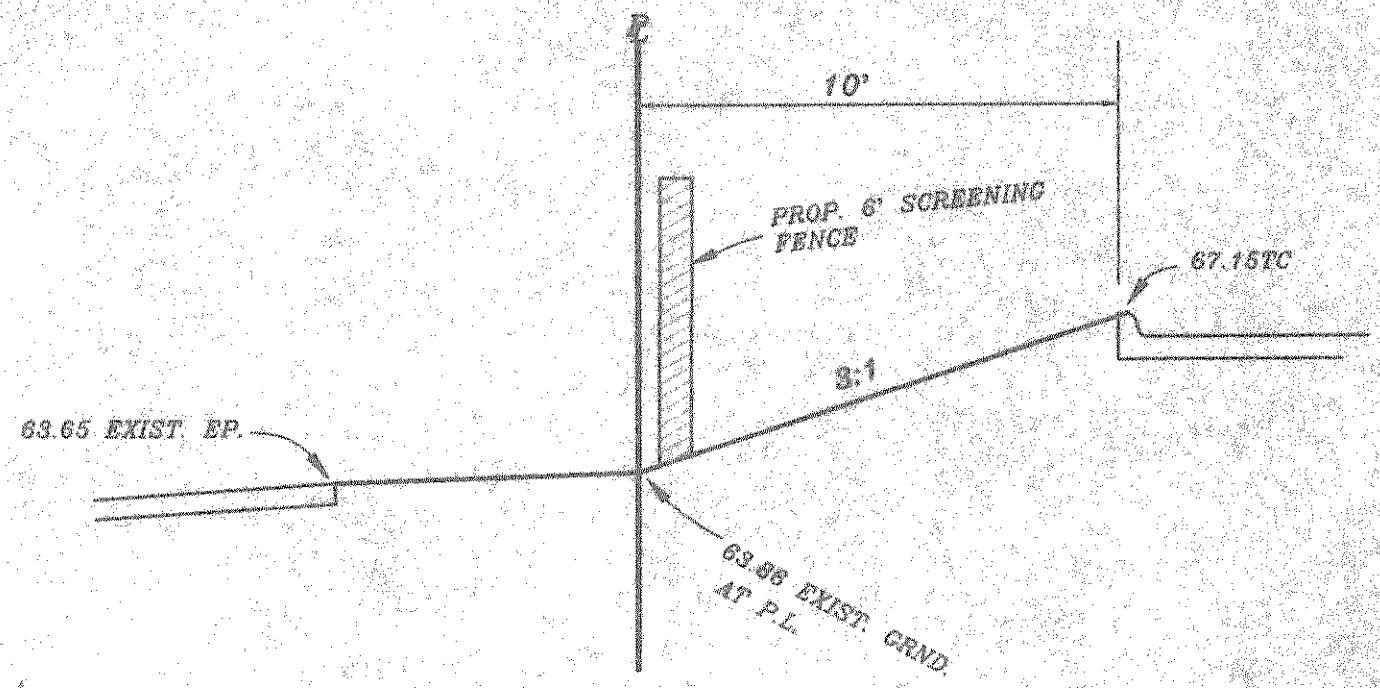

SECTION B-B

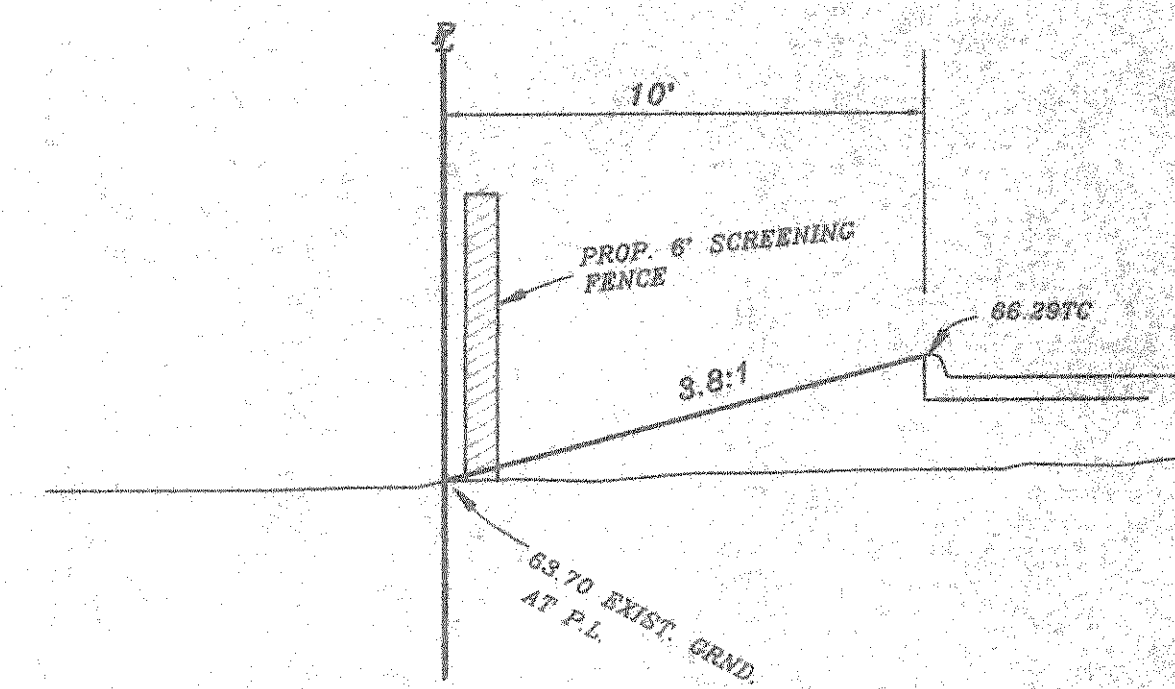

CURVE	RADIUS	LENGTH	TANGENT	CHORD	BEARING	DELTA
C1	1497.00'	283.86'	132.31'	263.49'	S15°38'40\"/>	
C2	3949.71'	208.61'	104.33'	208.60'	N71°29'50\"/>	

HAROLD L. EVANS CONSULTING ENGINEER P.O. BOX 29365 2931 CUS THOMASSON ROAD, SUITE 102 DALLAS, TEXAS 75228 (214) 328-8133		GRADING AND UTILITY PLAN HOLLEY ADDITION B.F. BOYDSTUN SURVEY, ABST. NO. 14 CITY OF ROCKWALL		SHEET NO. 4 6 408 NO. 3755
DATE 6/20/97	SCALE 1" = 20'	DESIGN H.L.E.	DRAWN	
REVISION DESCRIPTION 87569RD				