


STATE HIGHWAY 66

APPROX. LIMITS 100 YEAR FLOOD

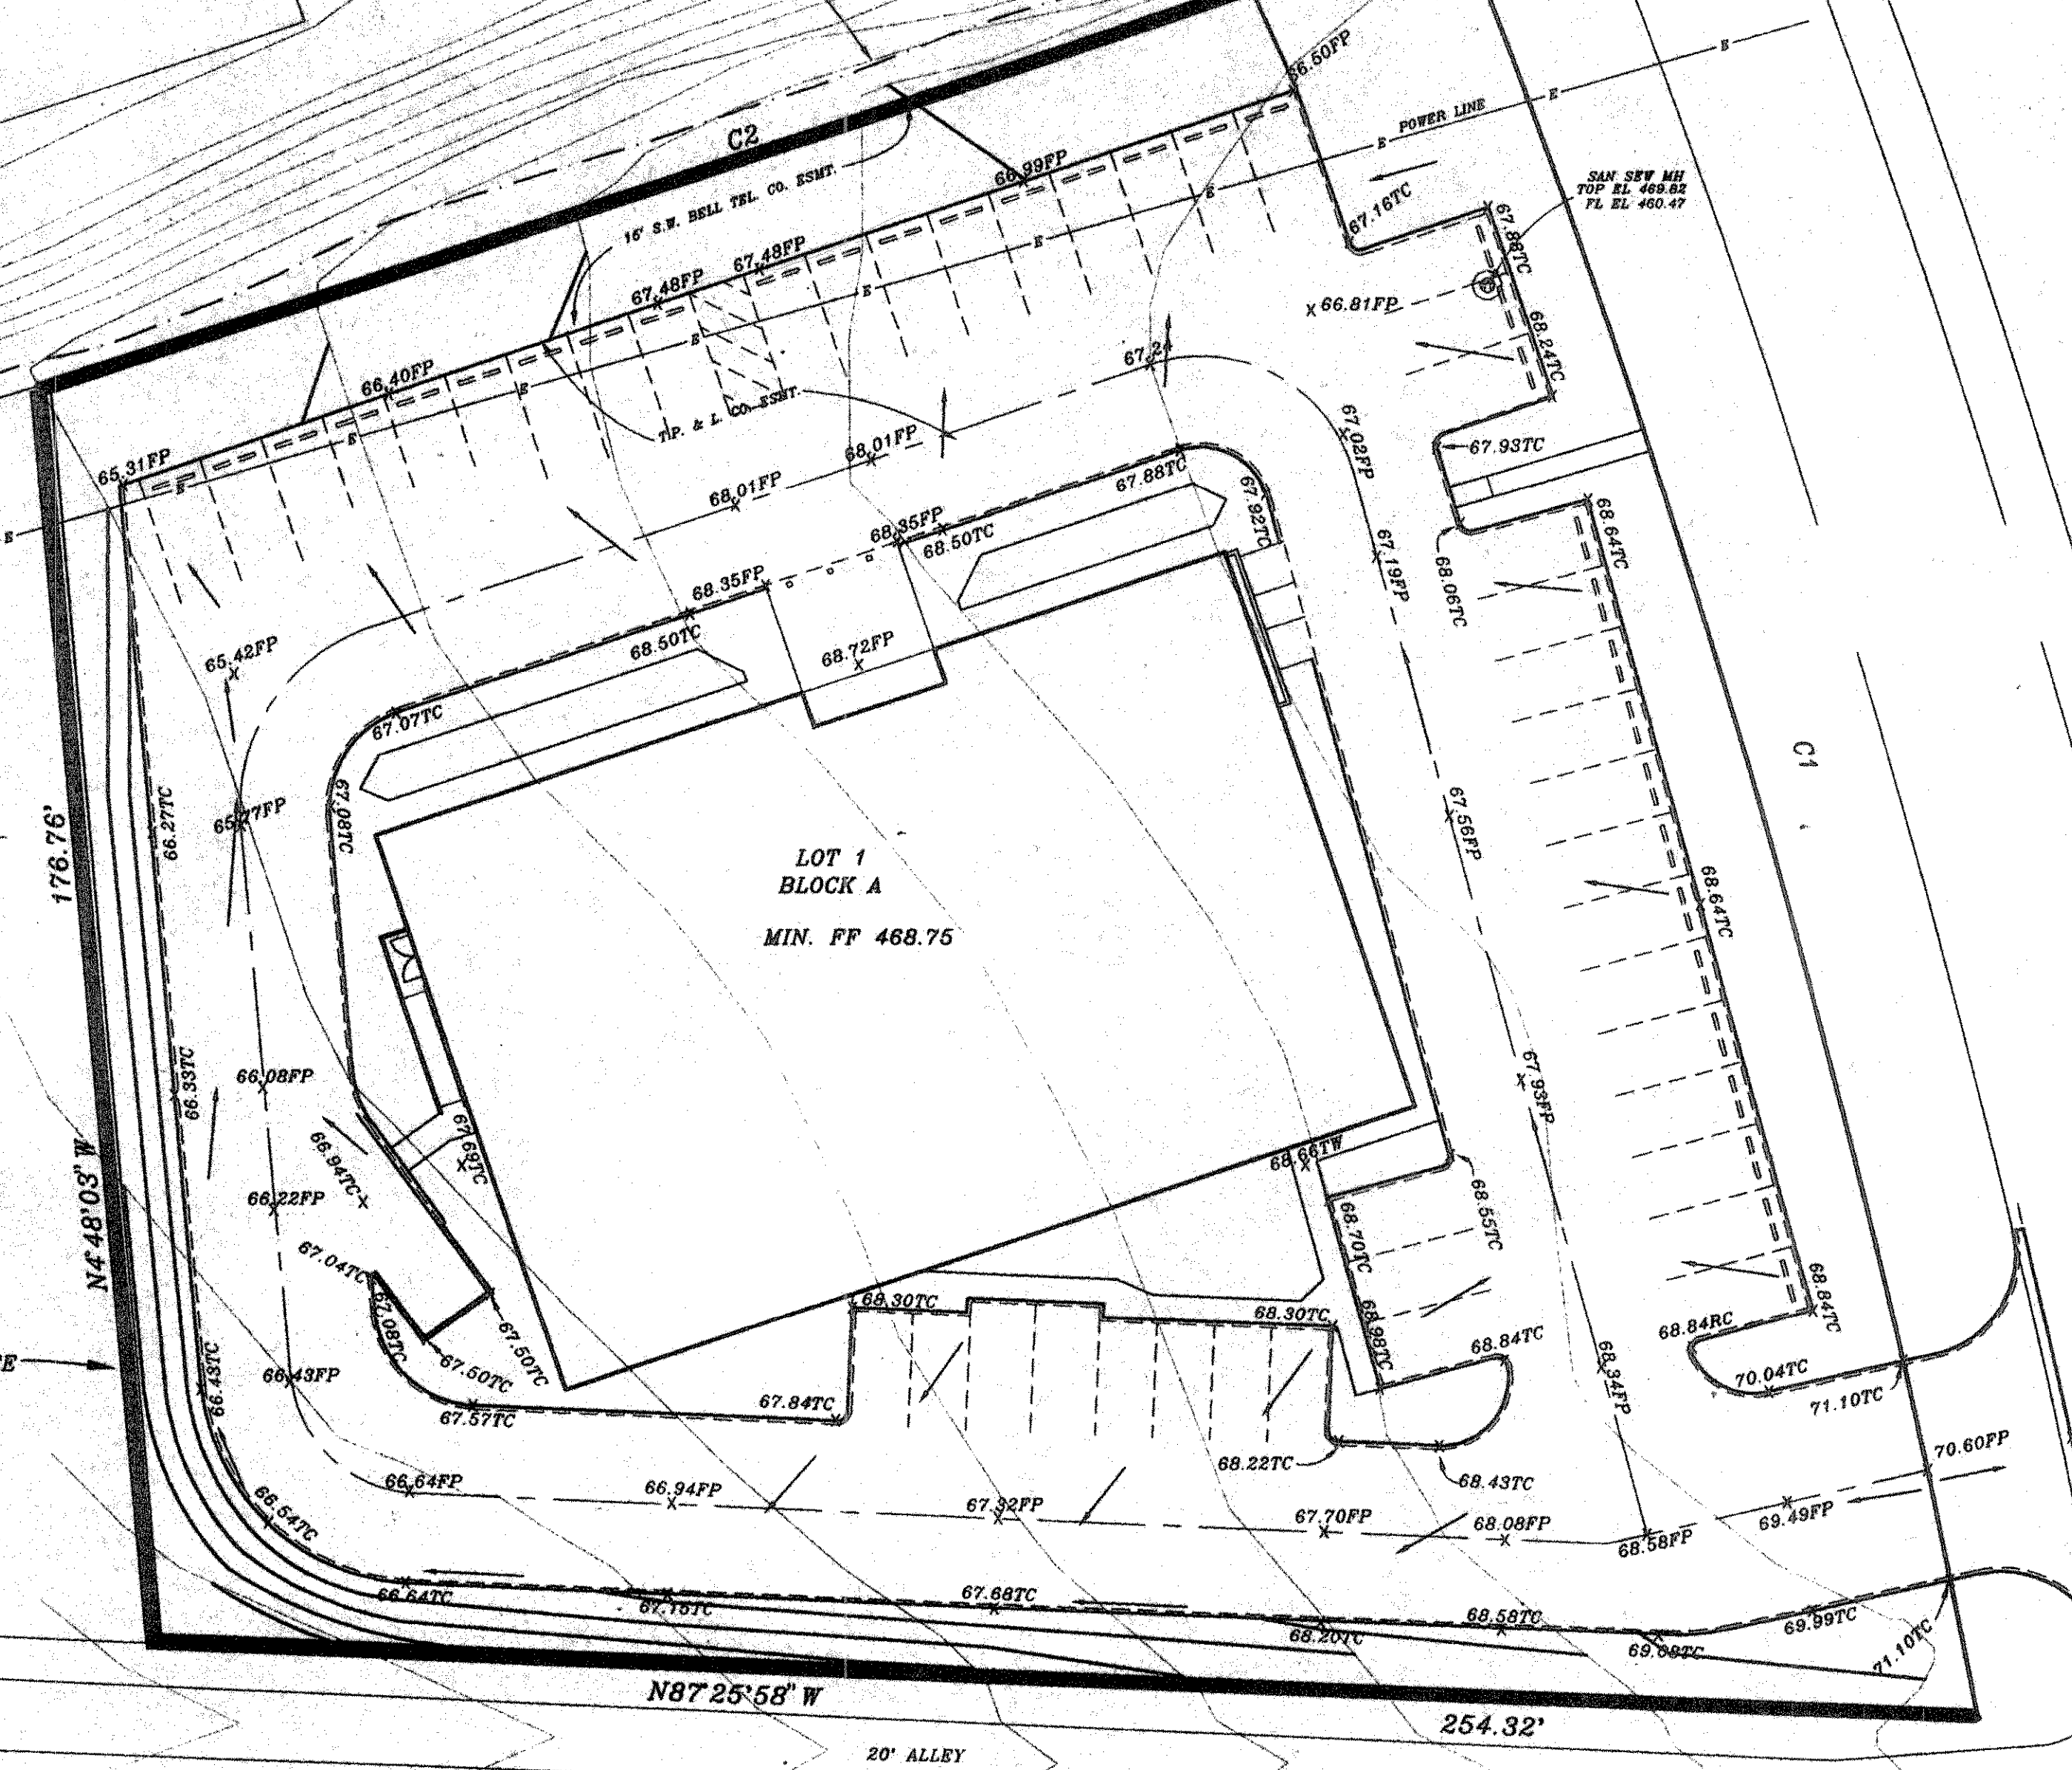

SLOPES TO BE SEEDED OR SODDED, WATERED, AND MAINTAINED UNTIL A GOOD STAND OF VEGETATION IS ATTAINED.


INSTALL 643 L.F. SILTATION FENCE

31  
BLOCK J  
STONEBRIDGE MEADOWS PHASE FIVE  
CAB. A. SLIDE 388

STONEBRIDGE MEADOWS PHASE FIVE  
CAB. A. SLIDE 388

BLOCK A

CURVE	RADIUS	LENGTH	TANGENT	CHORD	BEARING	DELTA
C1	1427.00'	263.86'	132.31'	263.49'	S16°38'40" E	10°35'40"
C2	3949.71'	208.61'	104.33'	208.58'	N71°29'50" E	03°01'34"

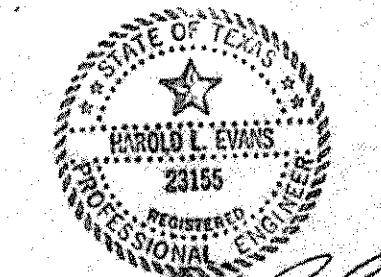

*Harold L. Evans*  
9-97

HAROLD L. EVANS CONSULTING ENGINEER P.O. BOX 28355 2381 GUS THOMASSON ROAD, SUITE 102 DALLAS, TEXAS 75228, (214) 328-8133		<b>EROSION CONTROL PLAN</b> <b>HOLLEY ADDITION</b> <b>B.F. BOYDSTUN SURVEY, ABST. NO. 14</b> <b>CITY OF ROCKWALL</b>		SHEET NO. 5
REV. 6/21/97 REV. 7/16/97	DATE 8/26/97 SCALE 1" = 20' DESIGN H.L.E. DRAWN	JOB NO. 9755		