


CONSTRUCTION PLANS for THE HOME DEPOT

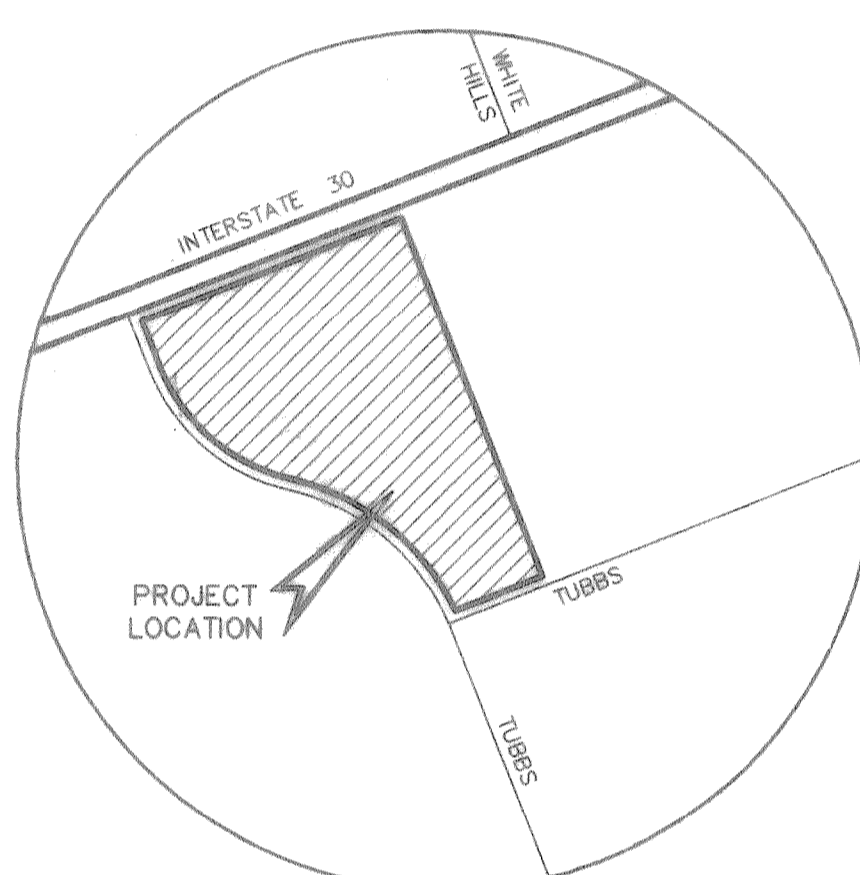

LOCATION MAP
MAPSCO PAGE 30C-G

LOCATION MAP
N.T.S.

INDEX

1	COVER SHEET
2-3	FINAL PLAT
4	SITE PLAN
5	TREESCAPE PLAN
C-1	GENERAL NOTES
C-2	EXISTING CONDITIONS & DEMOLITION PLAN
C-3	DIMENSION CONTROL PLAN
C-4	PAVING PLAN
C-5	GRADING PLAN
C-6	STORM WATER POLLUTION PREVENTION PLAN
C-7	STORM WATER POLLUTION PREVENTION DETAILS
C-8	DRAINAGE AREA MAP
C-9	DETENTION POND CALCULATIONS
C-10	DRAINAGE PLAN
C-11	STORM SEWER PROFILES
C-12	DETENTION POND DETAILS
C-13	UTILITY PLAN
C-14	LANDSCAPE PLAN
C-15	IRRIGATION PLAN
C-16	LANDSCAPE/IRRIGATION DETAILS
C-17	CIVIL DETAILS
C-18	WATERLINE PROFILE

PROJECT DIRECTORY

CITY OF ROCKWALL
205 W. RUSK
ROCKWALL, TEXAS 75087-3699
(972) 771-7700

CLIENT:
HOME DEPOT USA, INC.
2800 FOREST LANE
DALLAS, TEXAS 75229
(972) 402-3920 DAVE CASSMAN

T.U. ELECTRIC
RON JORDAN
124 WEST DAVIS
MESQUITE, TEXAS 75149
(972) 216-2810

LONE STAR GAS
DINAH WOOD
1310 HWY. 66
GARLAND, TEXAS 75040
(972) 573-3704

ARCHITECT:
JAMES A. SCHMITT
CASCO CORPORATION
10877 WATSON ROAD
ST. LOUIS, MISSOURI 63127
(314) 821-1100

SOUTHWESTEN BELL
DALE INGERSOLL
1255 TAVAROS #306
DALLAS, TEXAS 75218
(972) 402-3920 DAVE CASSMAN

INTERSTATE 30 IN ROCKWALL, TEXAS

Michael D. Clark
MICHAEL D. CLARK
REGISTERED
SURVEYOR
63290
9-10-97

Winkelmann & Associates, Inc.

CONSULTING CIVIL ENGINEERS ■ SURVEYORS
12800 HILLCREST ROAD, SUITE 200
DALLAS, TEXAS 75230 (972) 490-7090
FAX (972) 490-7099

ASBULT
Winkelmann & Associates, Inc. hereby states that this plan, to the best of our knowledge is "As Built." Modifications from the originally approved construction documents have been made as per information provided by the contractor. Winkelmann & Associates, Inc. does not certify as to the correctness or quality of construction as no field inspection was performed.