




IRRIGATION NOTES

1. IRRIGATION LINES ARE SOMETIMES SHOWN OUTSIDE PLANTING BEDS FOR GRAPHIC CLARITY ONLY. ADJUST INSIDE BEDS ON SITE.
2. AVOID TRENCHING WITHIN DRIP LINE OF EXISTING TREES. WHERE NECESSARY TRENCH RADIALLY RATHER THAN ACROSS ROOT SYSTEM.
3. MAIN LINE TO BE 3\"/>

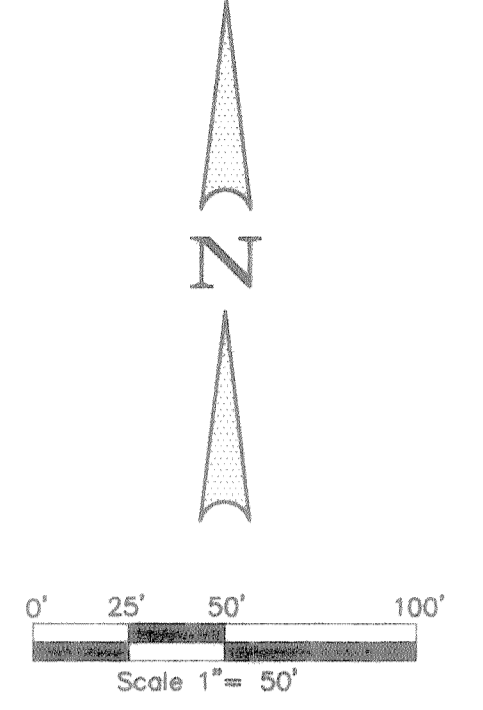

LEGEND

- ⊙ 2" METER
- ⊗ 2' DOUBLE CHECK/DOUBLE GATE VALVE
- ⊙ RAINBIRD CONTROLLER CSP-16 LX+
- ⊙ RAINBIRD RAIN CHECK
- ⊙ FREEZE SENSOR
- △ QUICK COUPLER
- ⊙ RAINBIRD CONTROL VALVE 200-PES
- RAINBIRD 1800 SAM/PES 8'R-Q
- ⊙ RAINBIRD 1800 SAM/PES 15'R (ARC AS REQD)
- ⊙ RAINBIRD 1800 SAM/PES 9'EST
- ⊙ RAINBIRD T22 SAM (1.0-QUARTER; 2.0-HALF; 4.0-FULL CIRCLE NOZZLE)
- RAINBIRD T40 SAM (3.0-QUARTER/HALF; 6.0-THREE QUARTER/FULL CIRCLE NOZZLE)

AS BUILT
 Winkelman & Associates, Inc. hereby states that this plan, to the best of our knowledge is "As Built". Modifications from the originally approved construction documents have been made as per information provided by the contractor. Winkelman & Associates, Inc. does not certify as to the correctness or quality of construction as no field inspection was performed.
 Winkelman & Associates, Inc. 5-13-98
 DATE

**JOHN R. FAIN
 ASLA**
 1201 Shirley Way
 Bedford, Texas 76022
 (817) 354-9654
 Phone & Fax

**LANDSCAPE
 ARCHITECT**

APPROV.	
REVISION	
DATE	
No.	
E.P. GAINES CHISUM SURVEY, ABST. No. 64 CITY OF ROCKWALL ROCKWALL COUNTY, TEXAS	
HOME DEPOT, U.S.A., INC. 2800 FOREST LANE DALLAS, TEXAS 75229	
IRRIGATION PLAN HOME DEPOT - ROCKWALL	
Scale: 1" = 50'	Date: 7/16/97
Designed By: M.D.C.	
Drawn By: R.D.L.	
Checked By: M.D.C.	
File: 079399R.DWG	
Project No.: 079399.01(2)	
SHEET	
C-15	
OF	
23	