


AS BUILT
 Winkelman & Associates, Inc. hereby states that this plan, to the best of our knowledge is "As Built." Modifications from the originally approved construction documents have been made as per information provided by the contractor. Winkelman & Associates, Inc. does not certify as to the correctness or quality of construction as no field inspection was performed.
 WINKELMAN & ASSOCIATES, INC. DATE 5-13-98

Scale: 1"=30'
 Date: 12/22/97
 Designed By: M.D.C.
 Drawn By: R.D.L.
 Checked By: M.D.C.
 File: 07939UPP.DWG
 Project No.: 07939.01(20)

12" WATER MAIN PROFILE
 HOME DEPOT - ROCKWALL

E.P. GAINES CHISUM SURVEY, ABST. No. 64
 CITY OF ROCKWALL
 ROCKWALL COUNTY, TEXAS
 HOME DEPOT, U.S.A., INC.
 2800 FOREST LANE
 DALLAS, TEXAS 75234

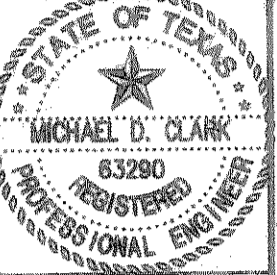

Winkelman & Associates, Inc.
 CONSULTING CIVIL ENGINEERS & SURVEYORS
 17800 MILKLET ROAD, SUITE 200
 DALLAS, TEXAS 75248
 (972) 480-7098
 (972) 480-7099 FAX