


DEVELOPMENT PLANS

HOMEBANK

CITY OF ROCKWALL, TEXAS

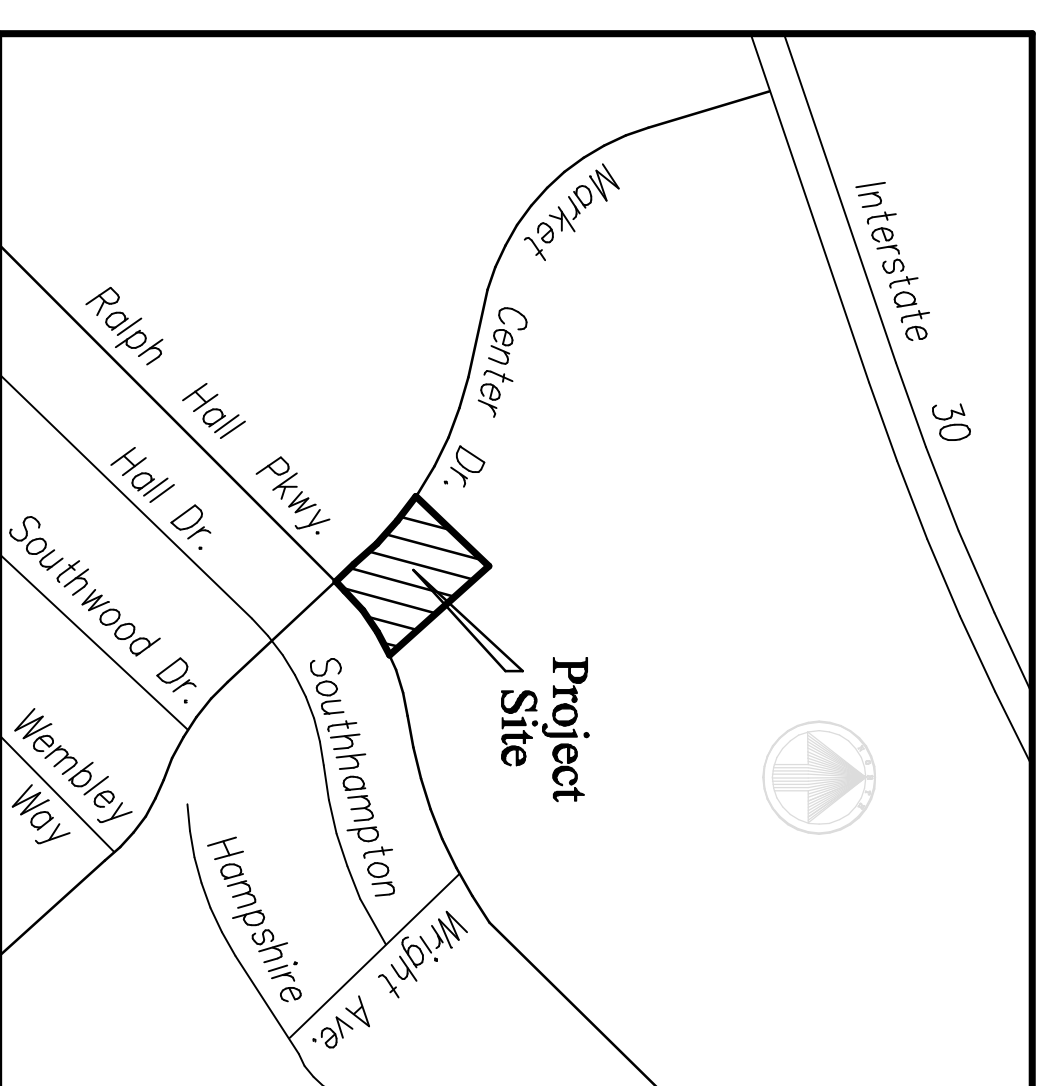

LOCATION MAP

INDEX of SHEETS

<u>Sheet No.</u>	<u>Title</u>
1	Cover Sheet
2-3	Replat
4	Paving Plan
5	Grading Plan
6	Water and Sanitary Sewer Plan
7	Drainage Plan
8	Drainage Calculations
9	Erosion Control Plan



THE SEAL APPEARING ON THIS DOCUMENT WAS AUTHORIZED BY CHRISTOPHER R. CUNNY, P.E. 65642

6-12-2011

Applicant ~ Developer

HOMEBANK

P. O. Box 909

Seagoville, Texas 75159

(972) 287-2030

~ Engineer ~



F.C. CUNY CORPORATION

#2 Horizon Court • Heath, Texas 75032 • (469) 402-7700
Texas Registered Engineering Firm F-7449

Record Drawings

June 2011