


Paving, Drainage and Utility Plans

HONDA OF ROCKWALL ADDITION

LOT 1, BLOCK 1

City Of Rockwall, Texas

Note:
Prior to beginning any construction or construction staking, it shall be the Contractor's responsibility to contact the civil engineer to insure that all parties are in possession of the most current set of CD's.

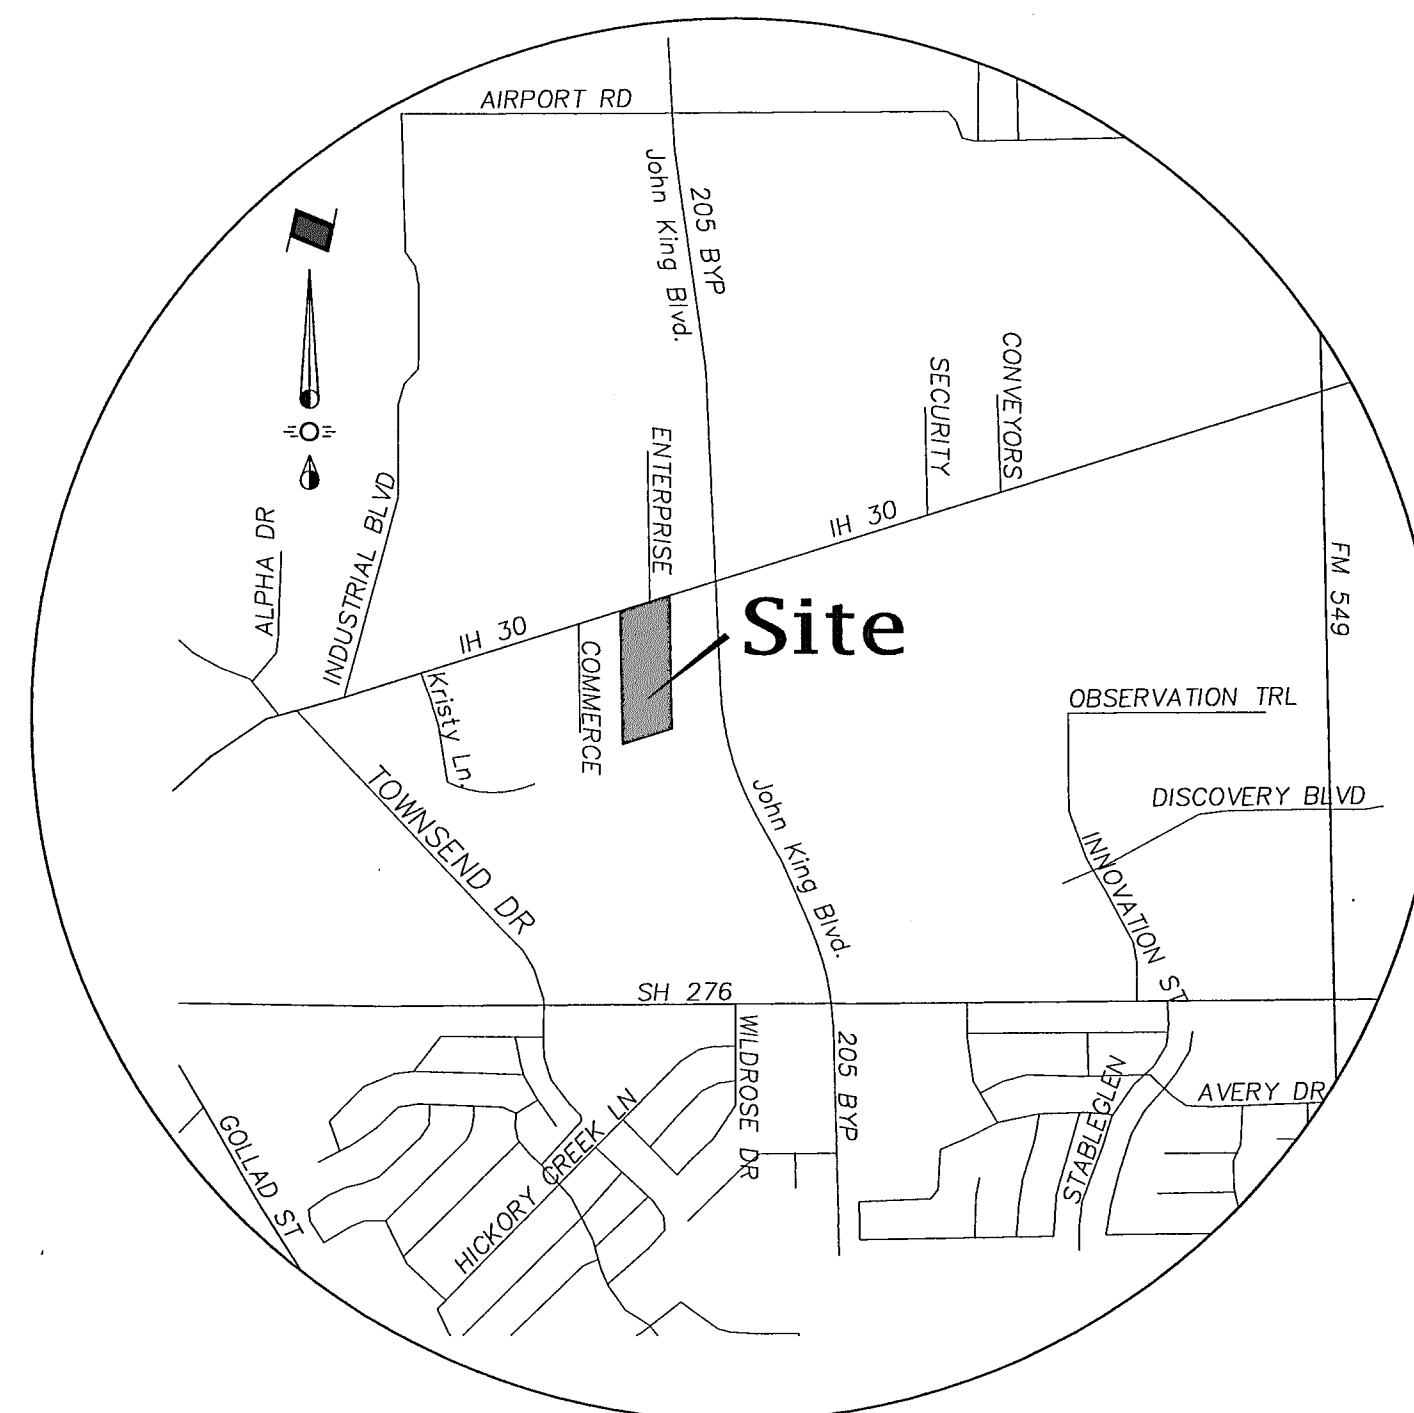


Vicinity Map
NTS

Index Of Drawings

- Cover Sheet
- Final Plat
- C 1 Site Plan
- C 2 PAVING PLAN
- C 3A TRAFFIC CONTROL PLAN
- C 3 DECELERATION LANE PAVING PLAN
- C 4 DECELERATION LANE GRADING & DRAINAGE PLAN
- C 5 GRADING PLAN
- C 6 DRAINAGE AREA MAP
- C 7 DRAINAGE PLAN
- C 8 STORM SEWER PROFILES
- C 9 WATER AND SANITARY PLAN
- C 10 EROSION CONTROL PLAN
- C 11 STORMWATER POLLUTION PREVENTION GUIDELINES
- C 12 SITE DETAILS
- SP 1 Retaining Wall Site Plan
- RW1-RW3 Retaining Wall Plans
- TXDOT Standard Details



765 Custer Road, Suite 100 • Plano, TX 75075 • (972) 422-0077 • TBPE No. F-2121

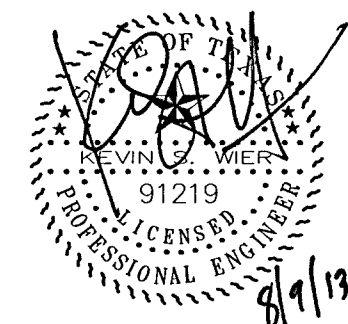

RECORD DRAWINGS

NOTE:
To the best of our knowledge Spinars Engineering, Inc. hereby states that this plan is a Record Drawing. The information provided is based on field surveying at the site and information provided by the contractor.

Prepared For:
Good Fulton & Farrell Architects
2808 Fairmount Street, Suite 300
Dallas, Texas 75201
Contact: Scott Sower
Telephone: 214-303-1500