



Plotted by: KSW, Plot Date: 8/20/13 8:50:05 AM

Drawing: 0-2111-20811-11-12 Honda of Rockwall 11-12 Storm Sewer, Sheet: B, Sheet: 8, Date: 8/20/13 8:57:28 AM

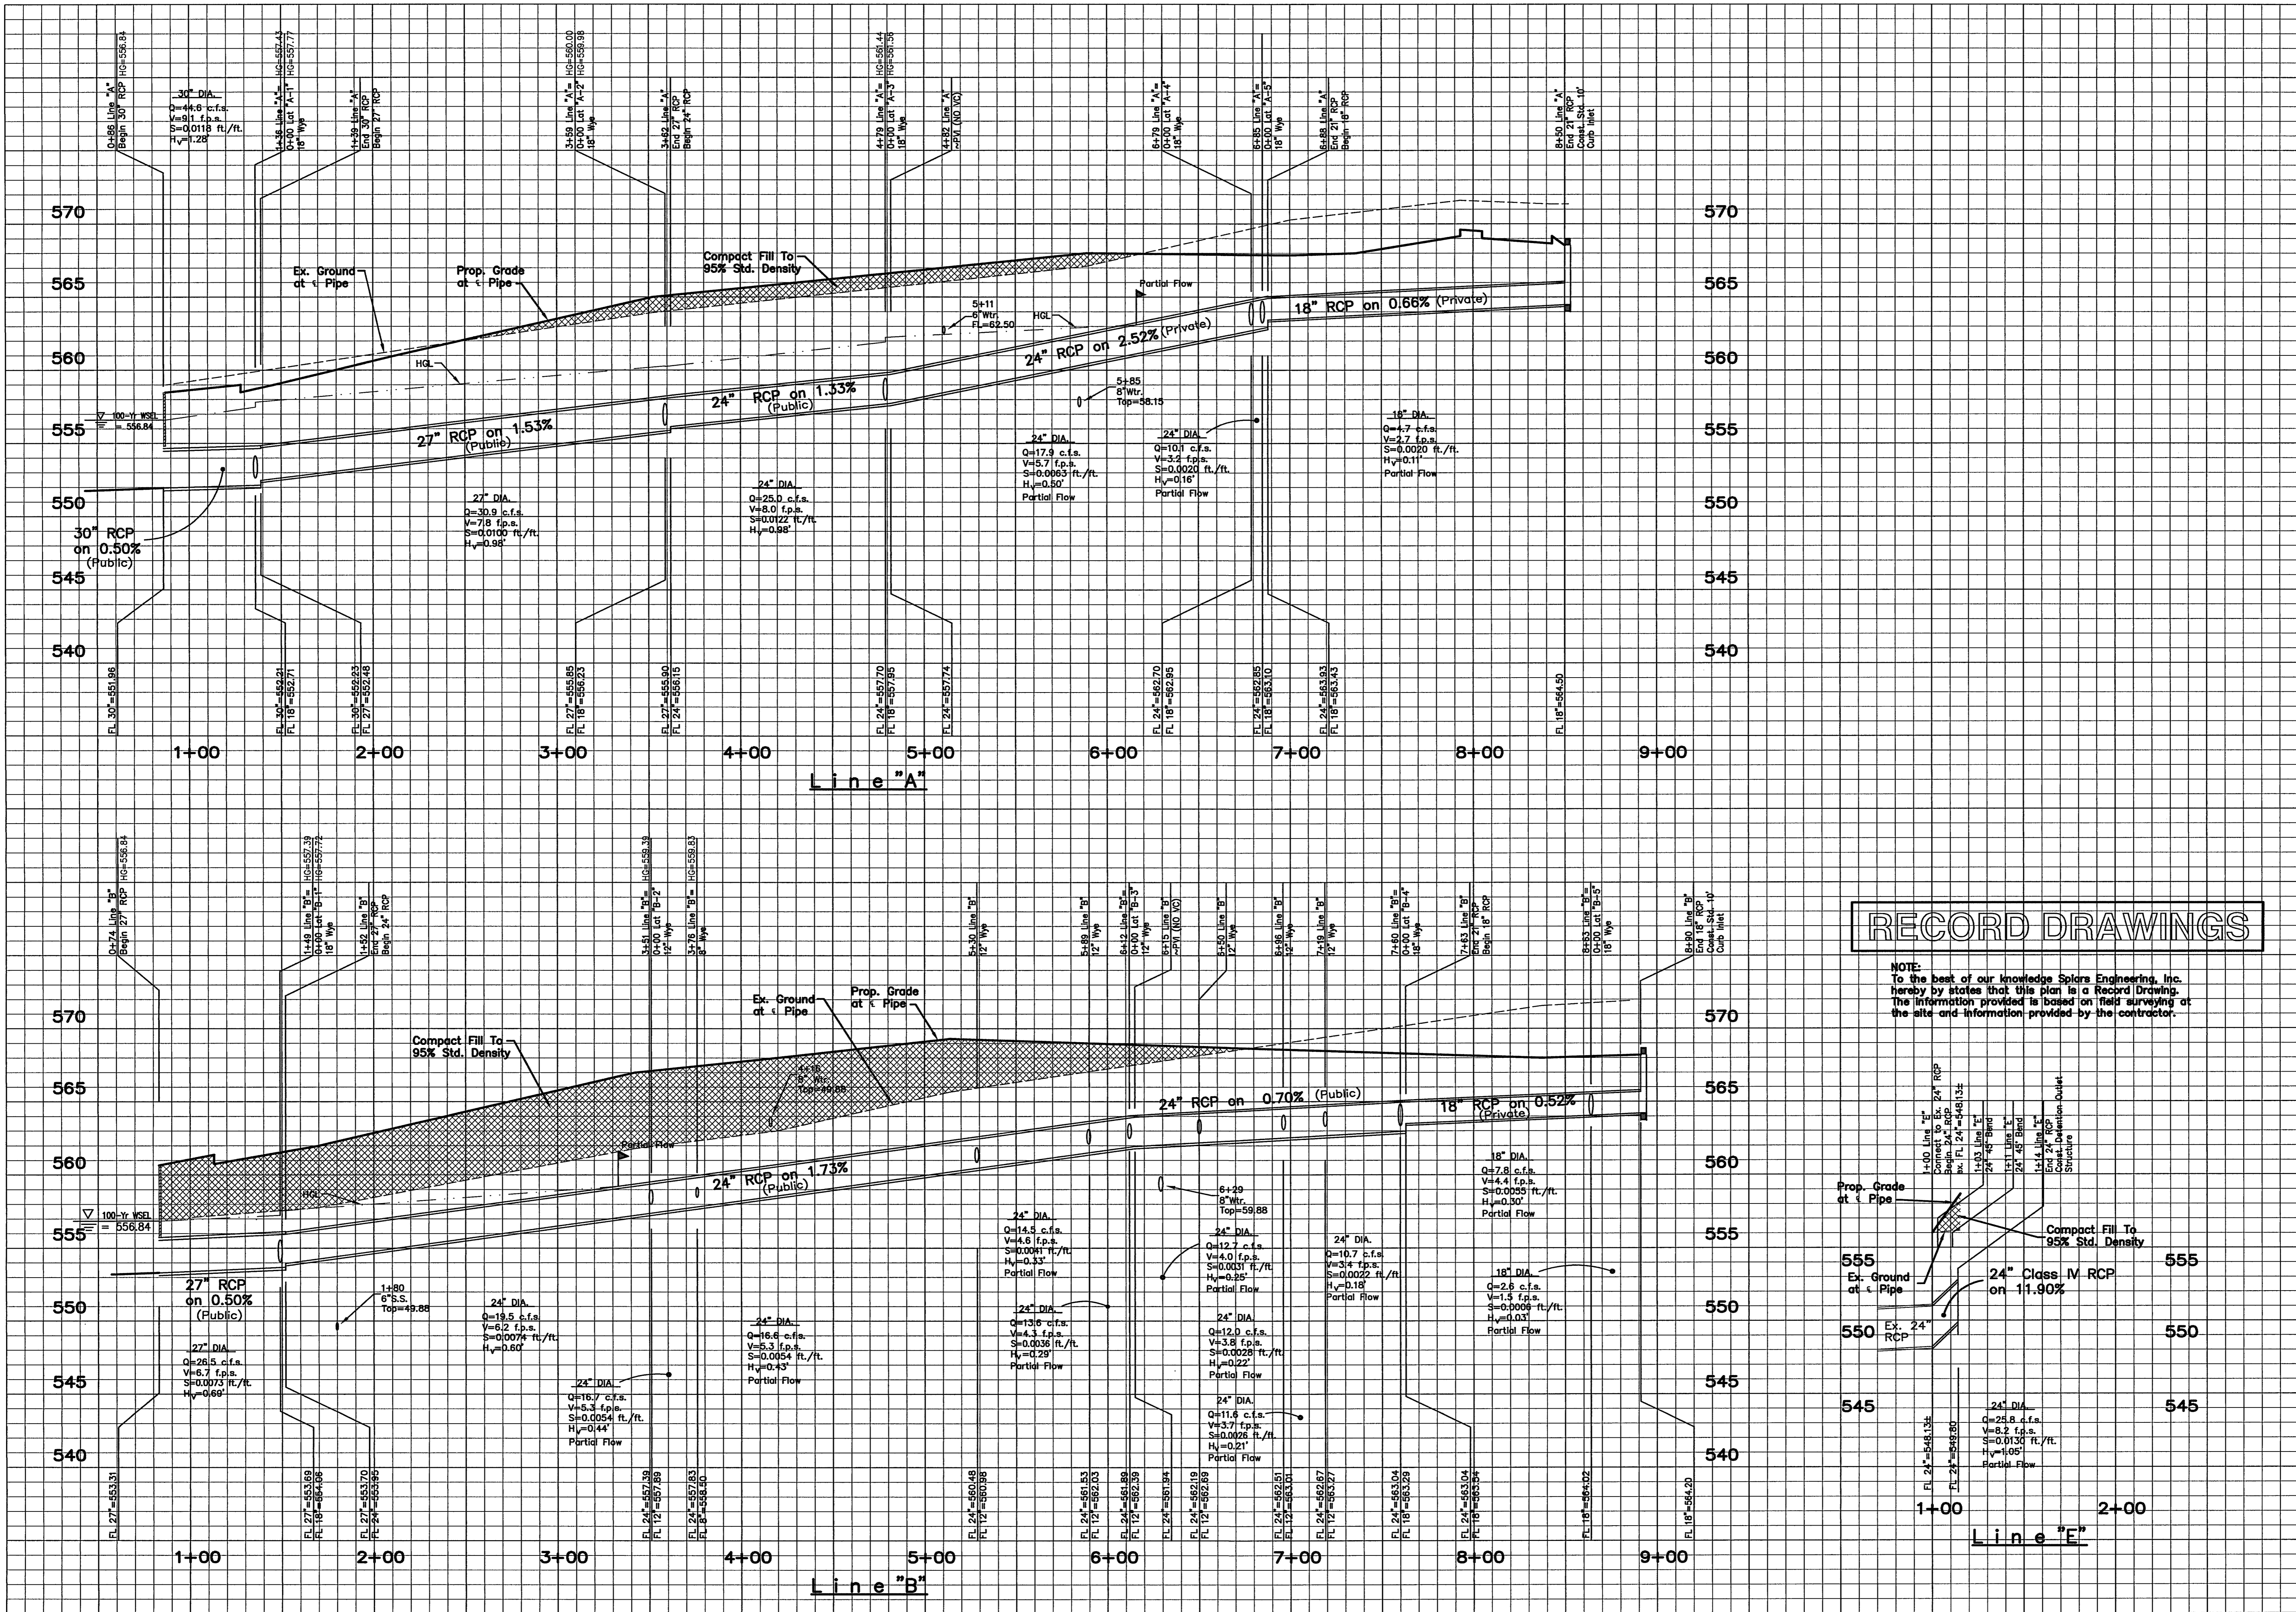

RECORD DRAWINGS

NOTE:
To the best of our knowledge Spars Engineering, Inc. hereby states that this plan is a Record Drawing. The information provided is based on field surveying at the site and information provided by the contractor.

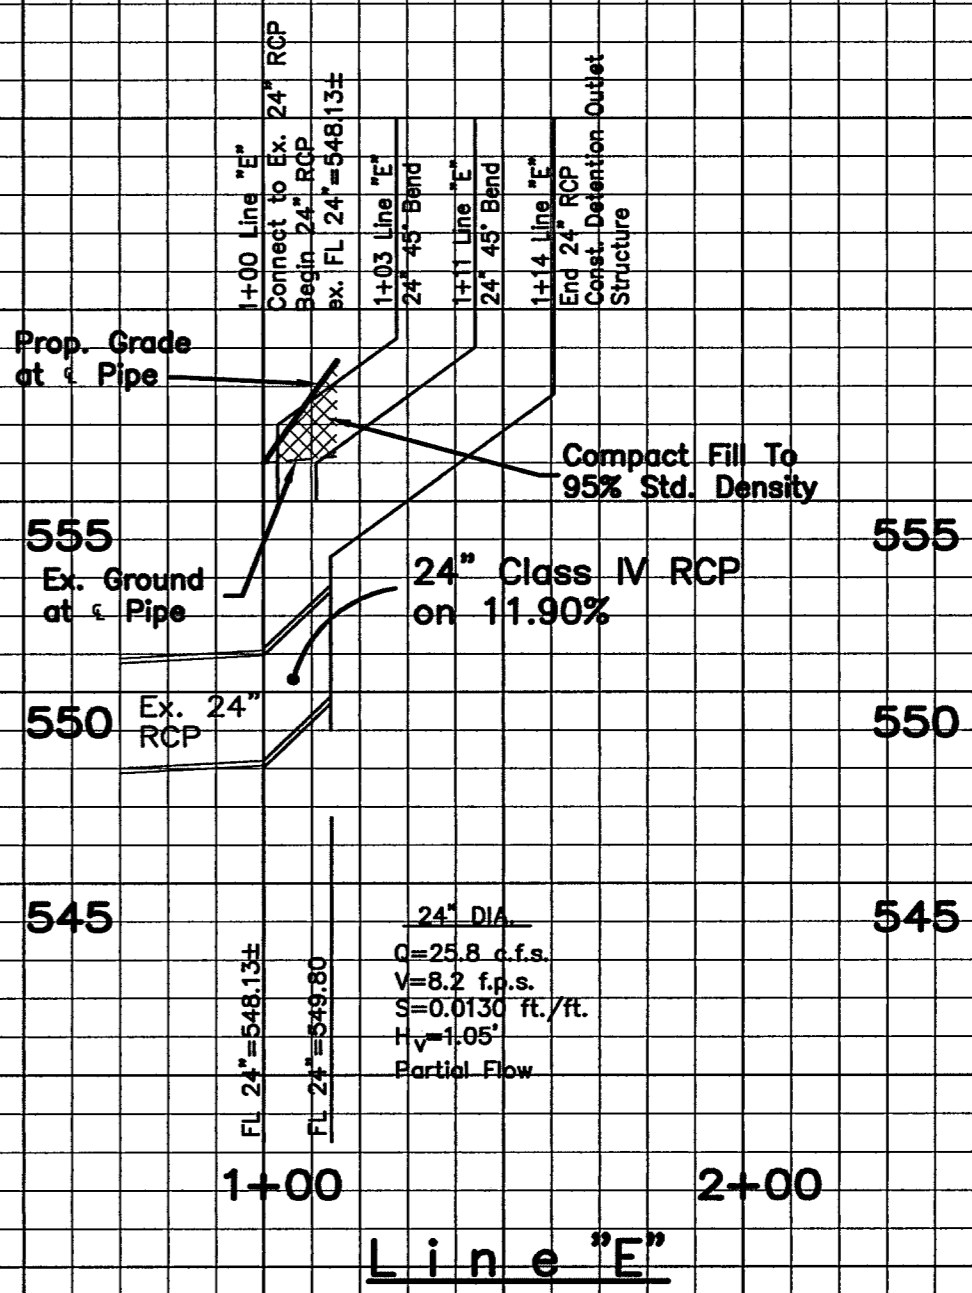

Revisions	Date
1	
2	
3	
4	
5	
6	
7	
8	
9	

Issue Dates:

Addendum 4 - Nov. 12, 2012


Scale: 1"=40'H 1"=5'V

Drawn By: AO

Checked by: KSW

Sheet of C 08 12
SEI No. 11-12
11-112-Strmprf

HONDA OF ROCKWALL ADDITION
LOT 1, BLOCK 1
ROCKWALL, TEXAS
STORM SEWER PROFILES

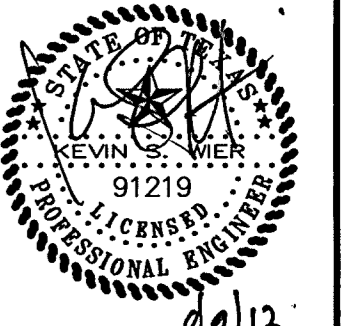

Spars
ENGINEERING
765 Custer Road, Suite 100 • Plano, TX 75075 • (972) 422-0077 • TBE No. F-2121