



HORIZ: 1"=40'
VERT: 1"=4'

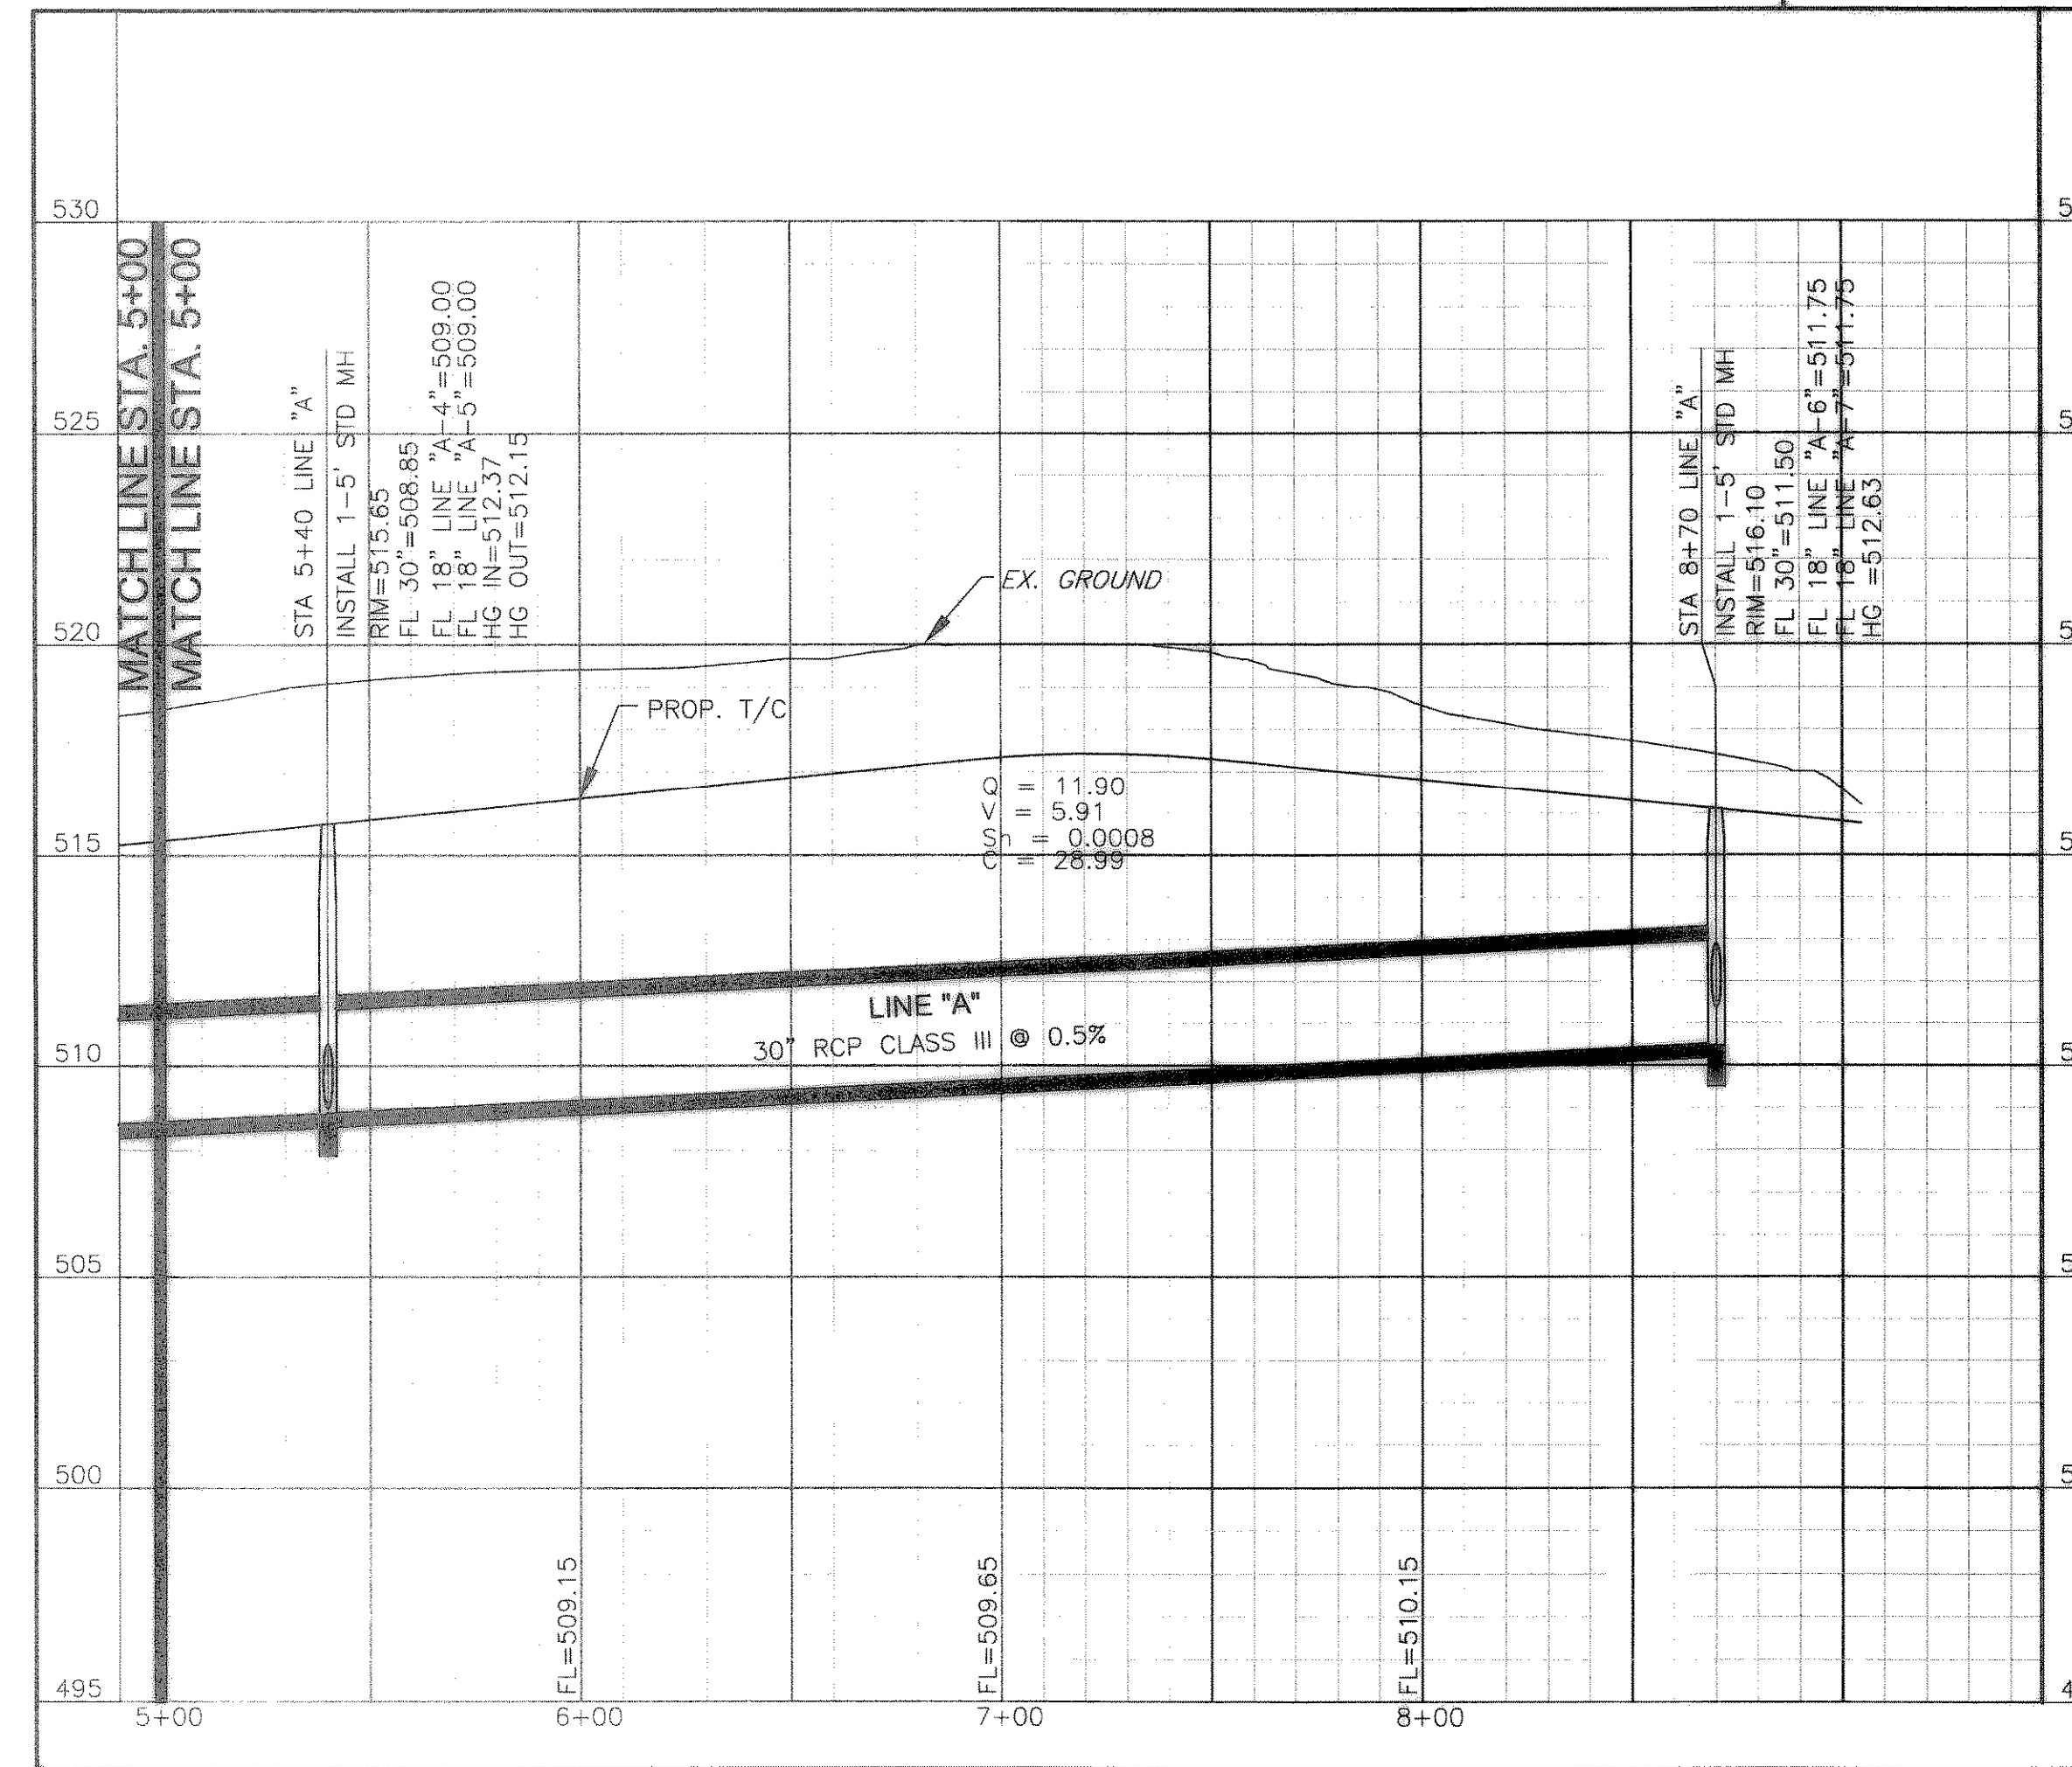

BENCH MARK
 ▲ IRON ROD FOUND IN THE R.O.W. OF HORIZON ROAD AND NORTHEAST CORNER OF HORIZON RIDGE MEDICAL PARK ADDITION
 ELEVATION (m.s.l.) 499.06

AS BUILT
 THIS IS TO VERIFY THAT CHANGES AND CORRECTIONS HAVE BEEN MADE TO CONFORM TO THE CONTRACTOR'S RECORD OF THIS PROJECT.

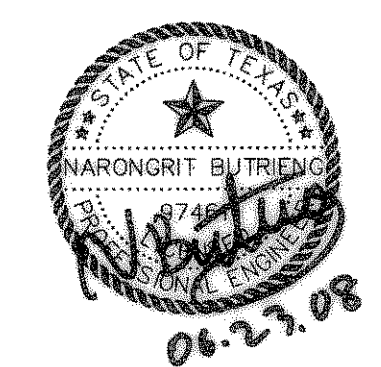

**PLAN AND PROFILE
 STORM DRAIN LINE "A" (2)**

**HORIZON RIDGE MEDICAL PARK
 CITY OF ROCKWALL, TEXAS**

PSA ENGINEERING
 17819 DAVENPORT ROAD, SUITE 215 DALLAS, TX 75252 (972) 248-9651

DESIGN	DRAWN	DATE	SCALE	CHECK	FILE	NO.
PSA	PSA	06/23/08	AS SHOWN	PSS	2616.HRM	C-8

AS BUILT