



SECTION "A-A"
NTS

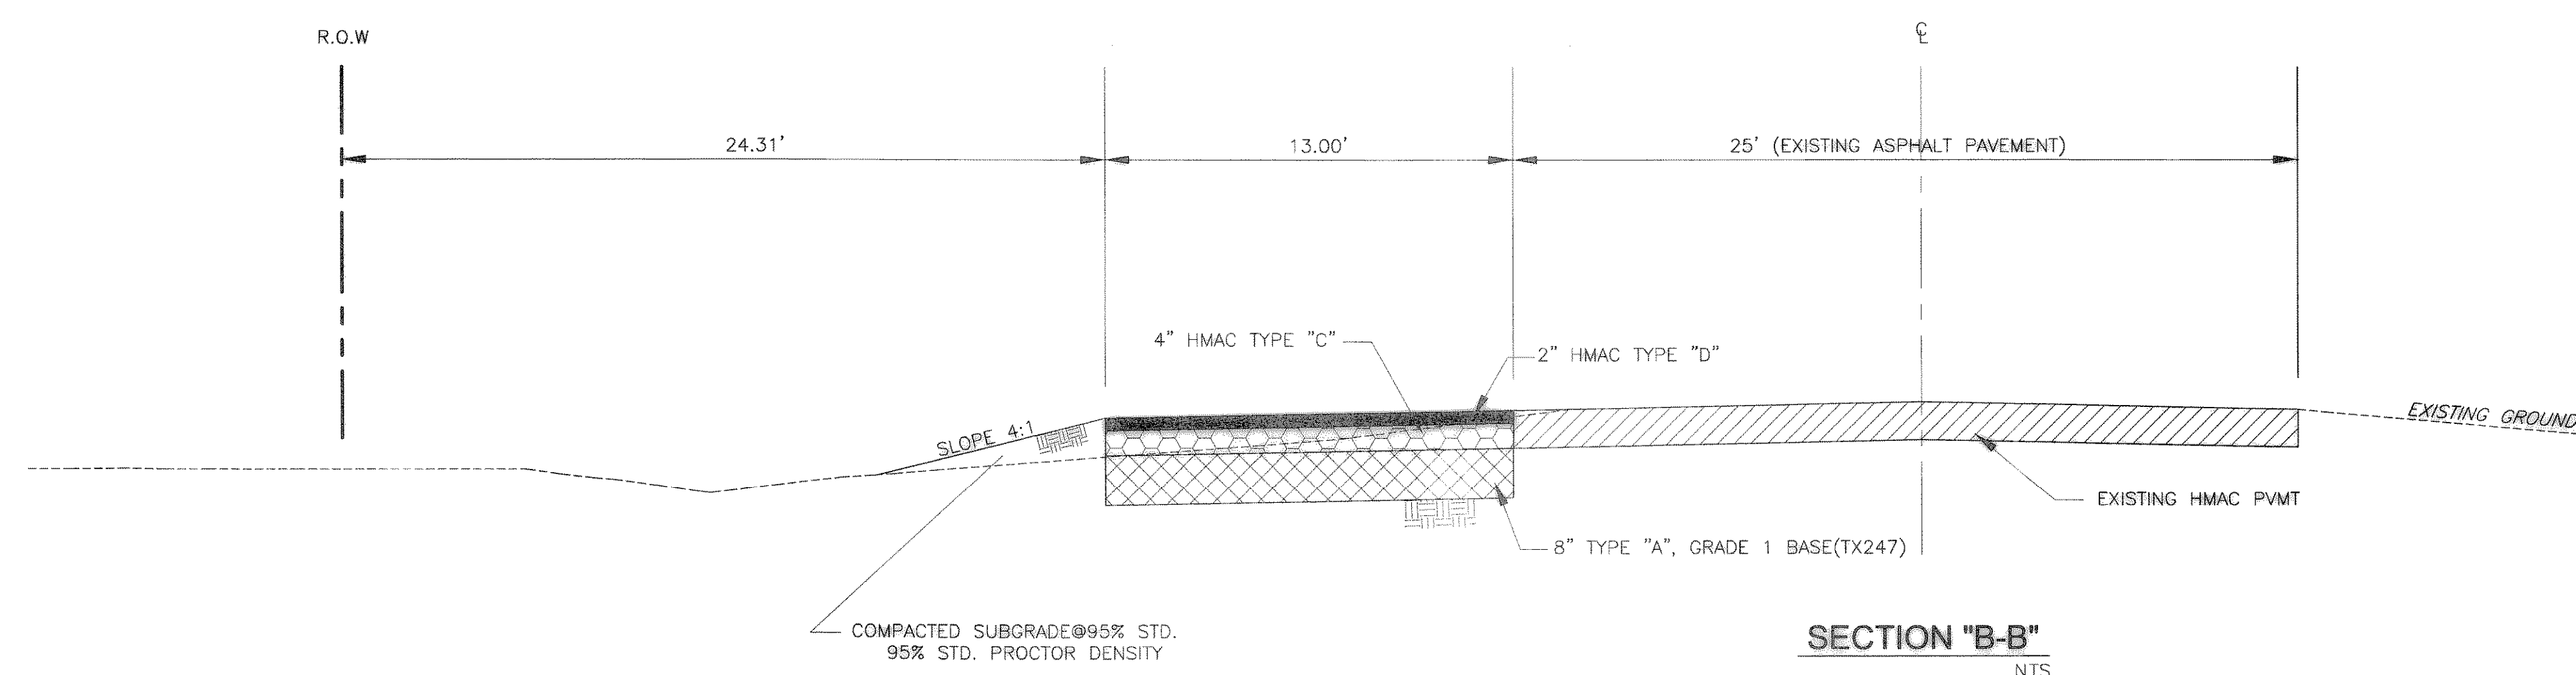

SECTION "B-B"
NTS

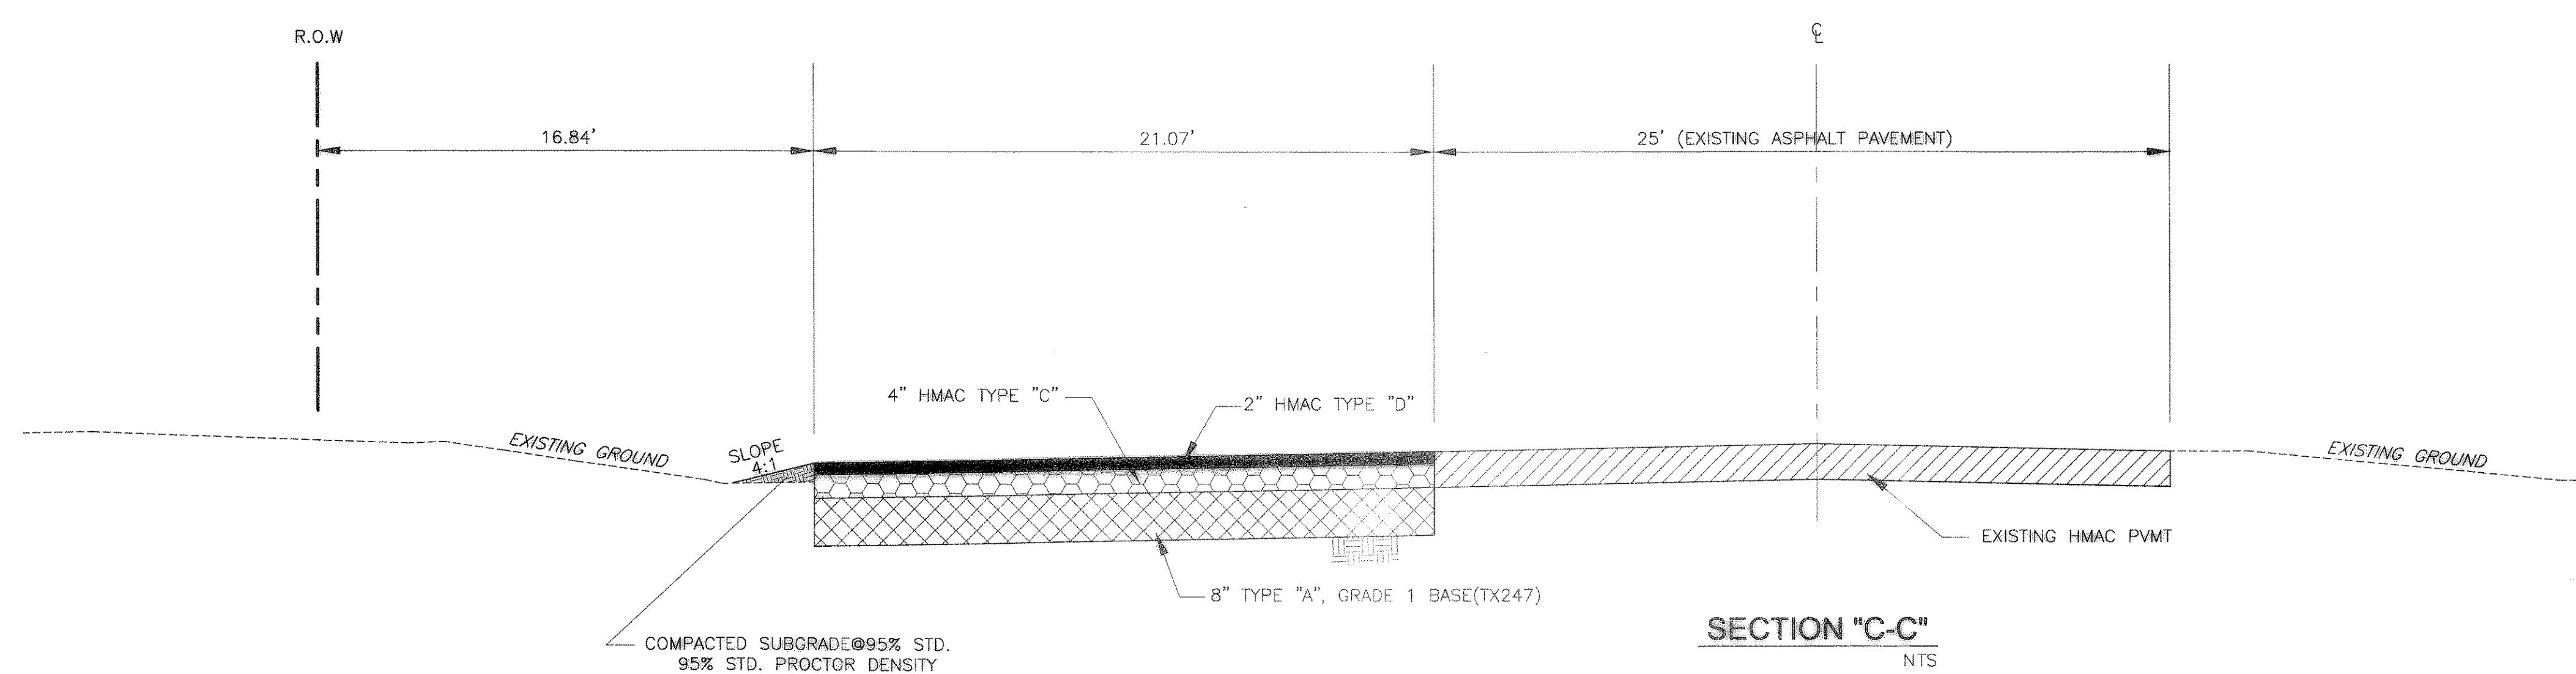

SECTION "C-C"
NTS

NOTE:
SEAL COAT ENTIRE WIDTH

AS BUILT
THIS IS TO CERTIFY THAT CHANGES AND CORRECTIONS HAVE BEEN MADE TO CONFORM TO THE CONTRACTOR'S RECORD OF THIS PROJECT.



CROSS SECTION DETAILS-1						
HORIZON RIDGE MEDICAL PARK						
CITY OF ROCKWALL, TEXAS						
PSA ENGINEERING						
17819 DAVENPORT ROAD, SUITE 215 DALLAS, TX 75262 (972) 248-9651						
DESIGN	DRAWN	DATE	SCALE	CHECK	FILE	NO.
PSA	PSA	06/23/08	AS SHOWN	PSS	2616.HRM	C-21

AS BUILT

I:\0616\0616.HRM\AS-BUILT\SET 1\C-21-23-25.dwg