



**SECTION "G-G"**  
NTS

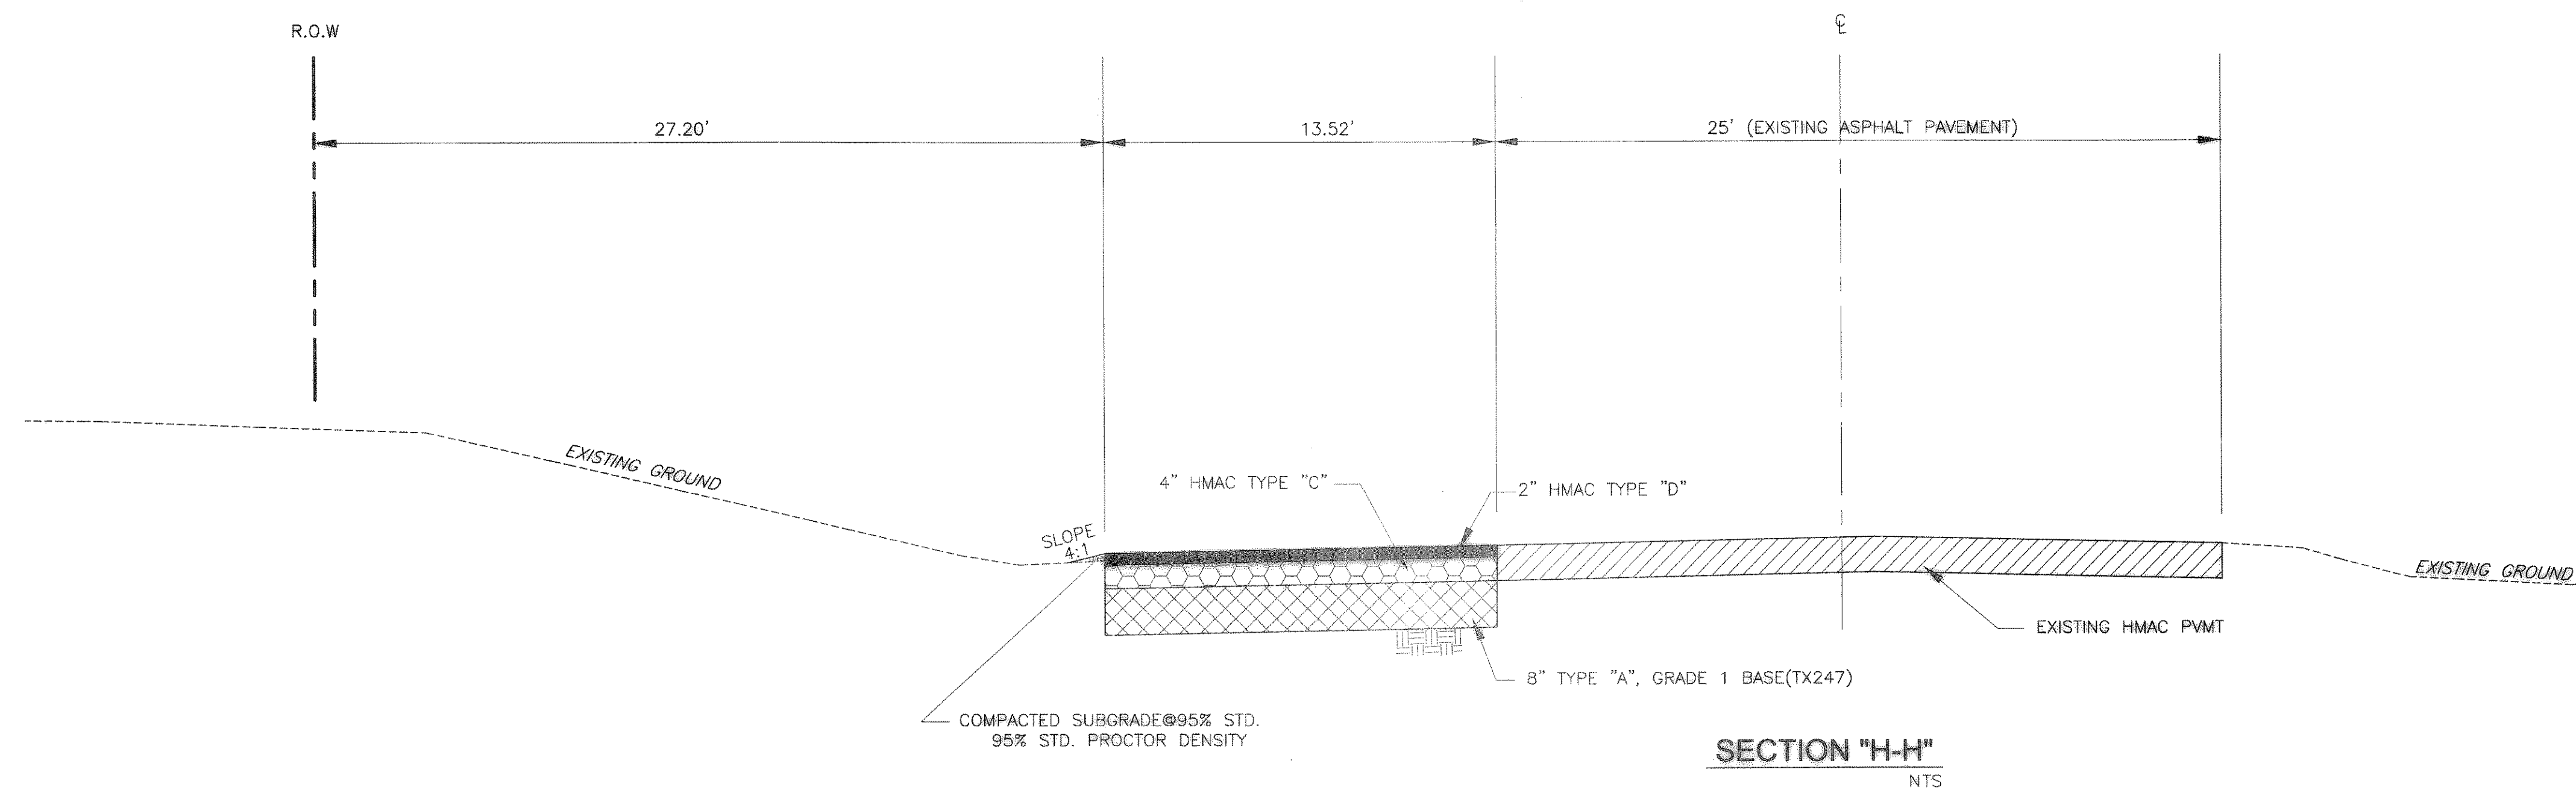

**SECTION "H-H"**  
NTS

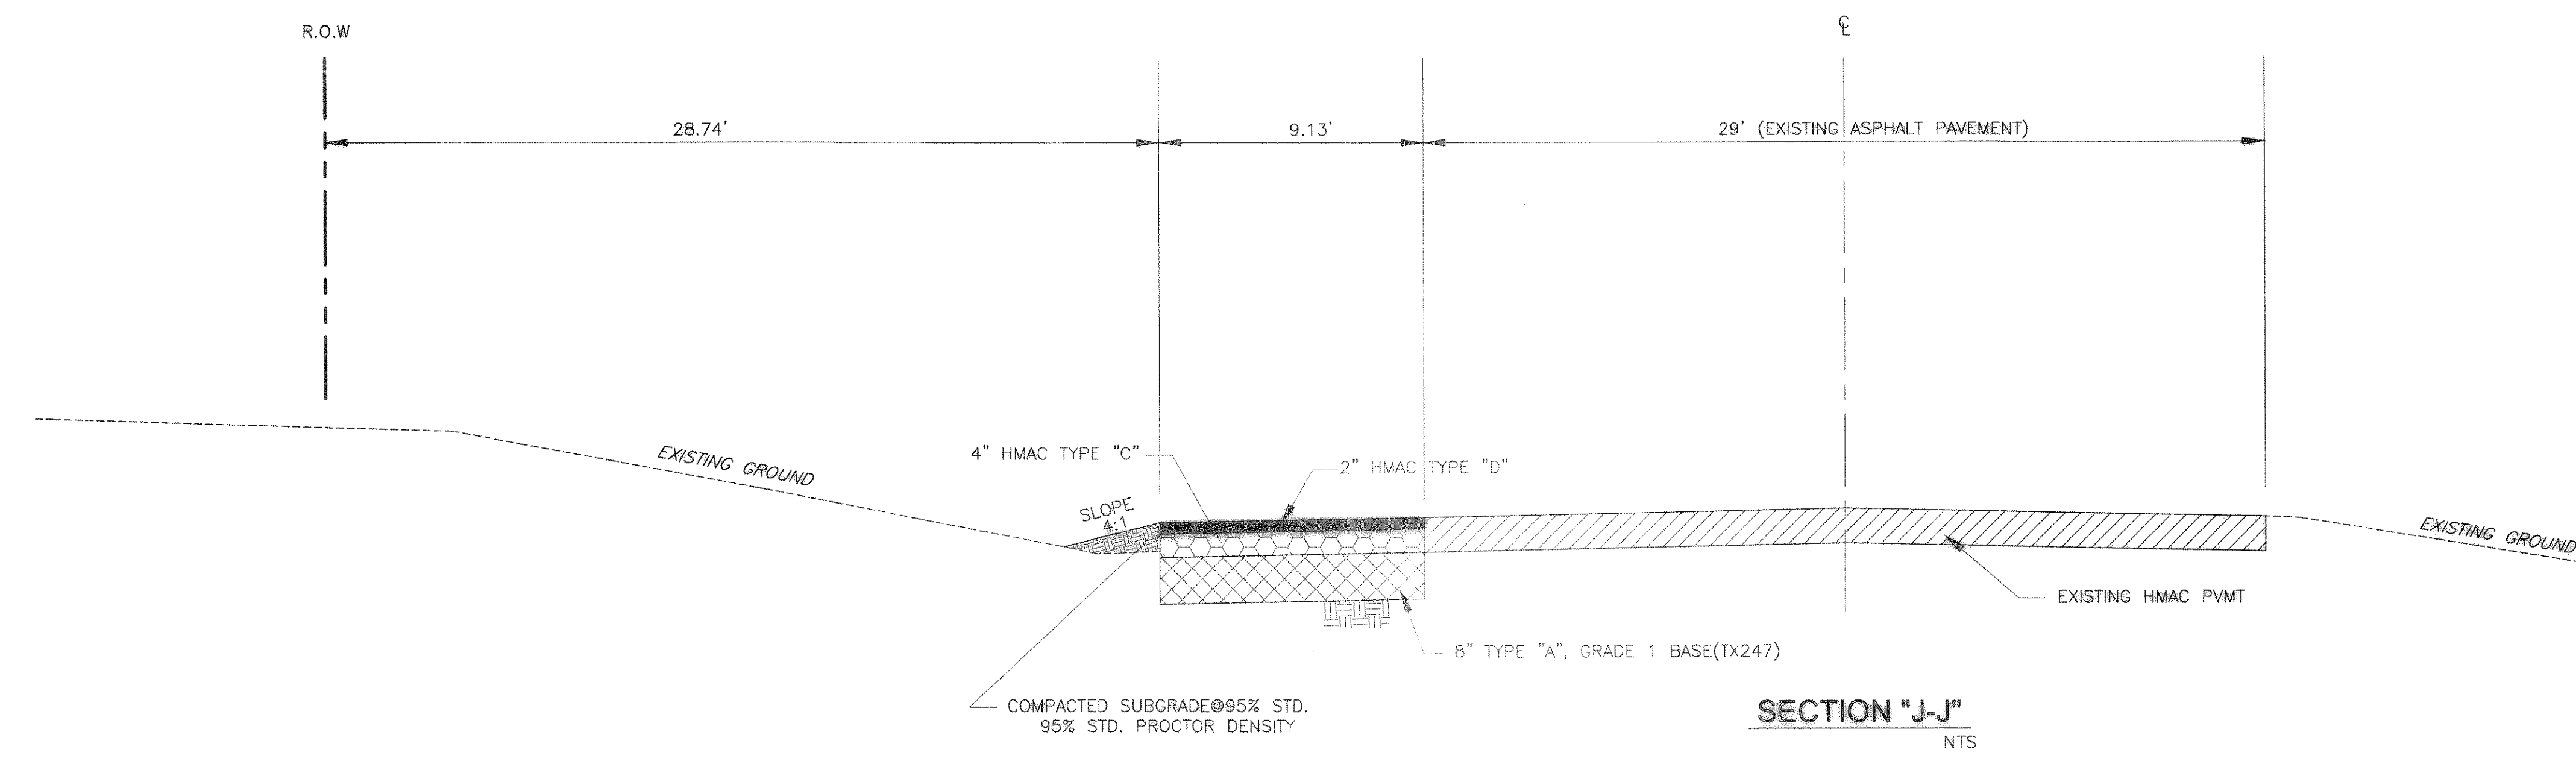

**SECTION "J-J"**  
NTS

**NOTE:**  
SEAL COAT ENTIRE WIDTH

**AS BUILT**  
THIS IS TO VERIFY THAT CHANGES AND CORRECTIONS HAVE BEEN MADE TO CONFORM TO THE CONTRACTOR'S RECORD OF THIS PROJECT.



CROSS SECTION DETAILS-3						
HORIZON RIDGE MEDICAL PARK						
CITY OF ROCKWALL, TEXAS						
PSA ENGINEERING						
17819 DAVENPORT ROAD, SUITE 215 DALLAS, TX 75252 (972) 248-9651						
DESIGN	DRAWN	DATE	SCALE	CHECK	FILE	NO.
PSA	PSA	06/23/08	AS SHOWN	PSS	2616.HRM	C-23

AS BUILT

V:\2006\2616.HRM\AS-BUILT\SET.1\C-23-23-24.dwg