




SECTION "K-K"
NTS

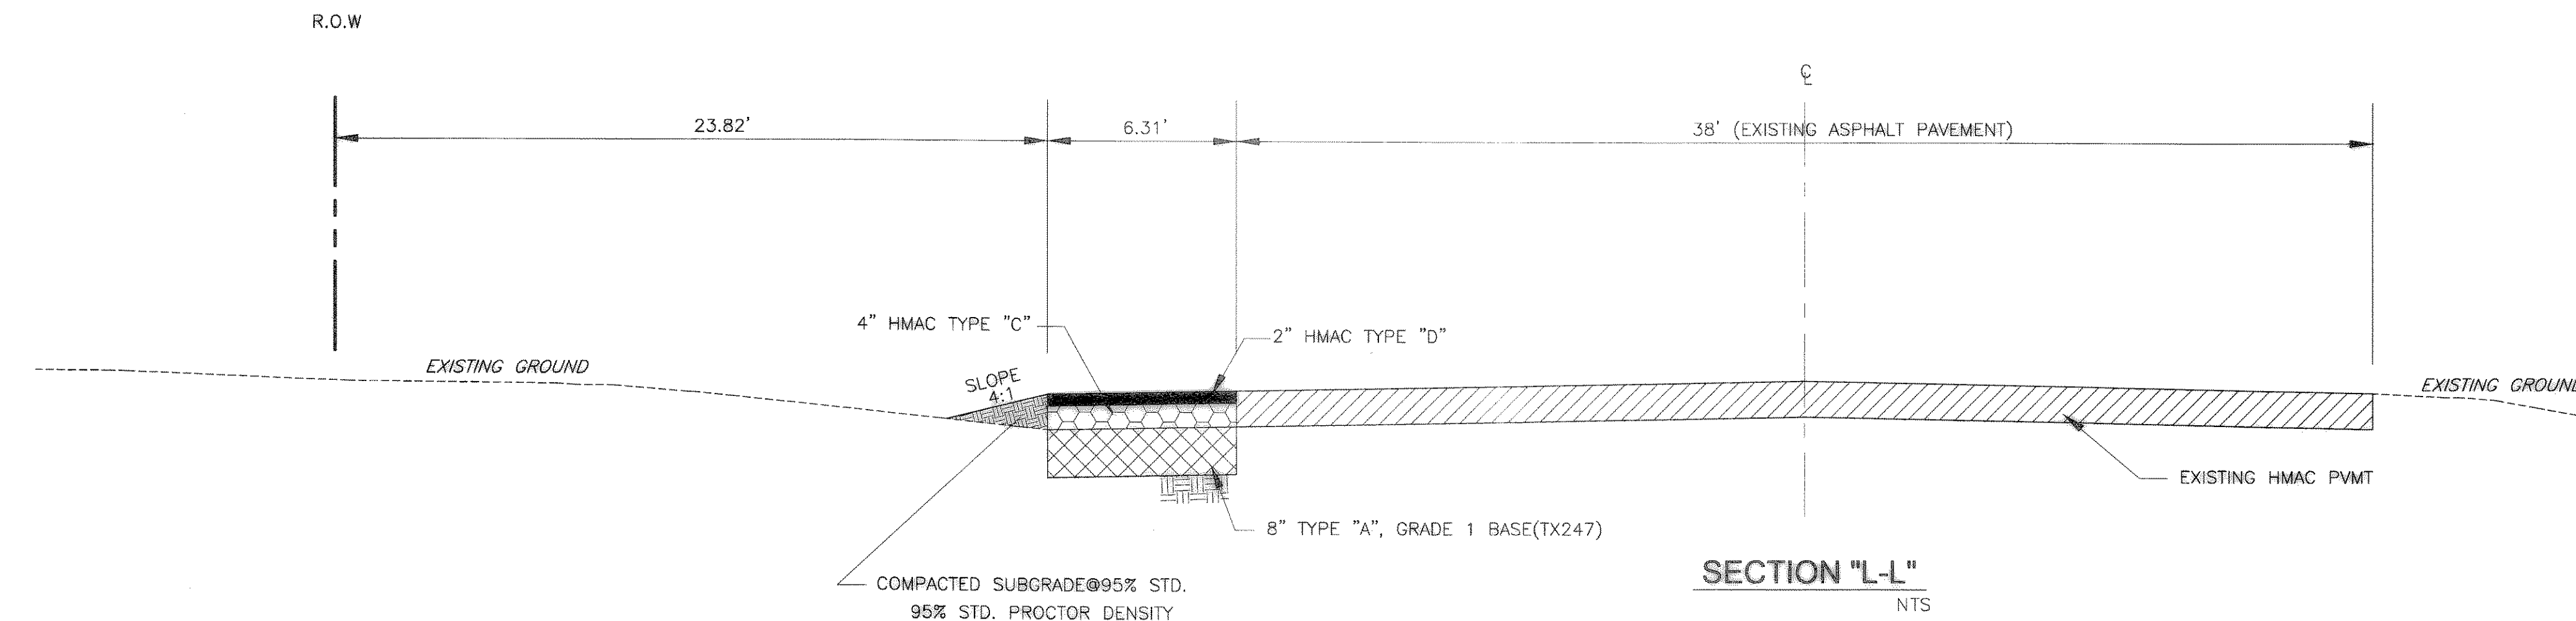

SECTION "L-L"
NTS

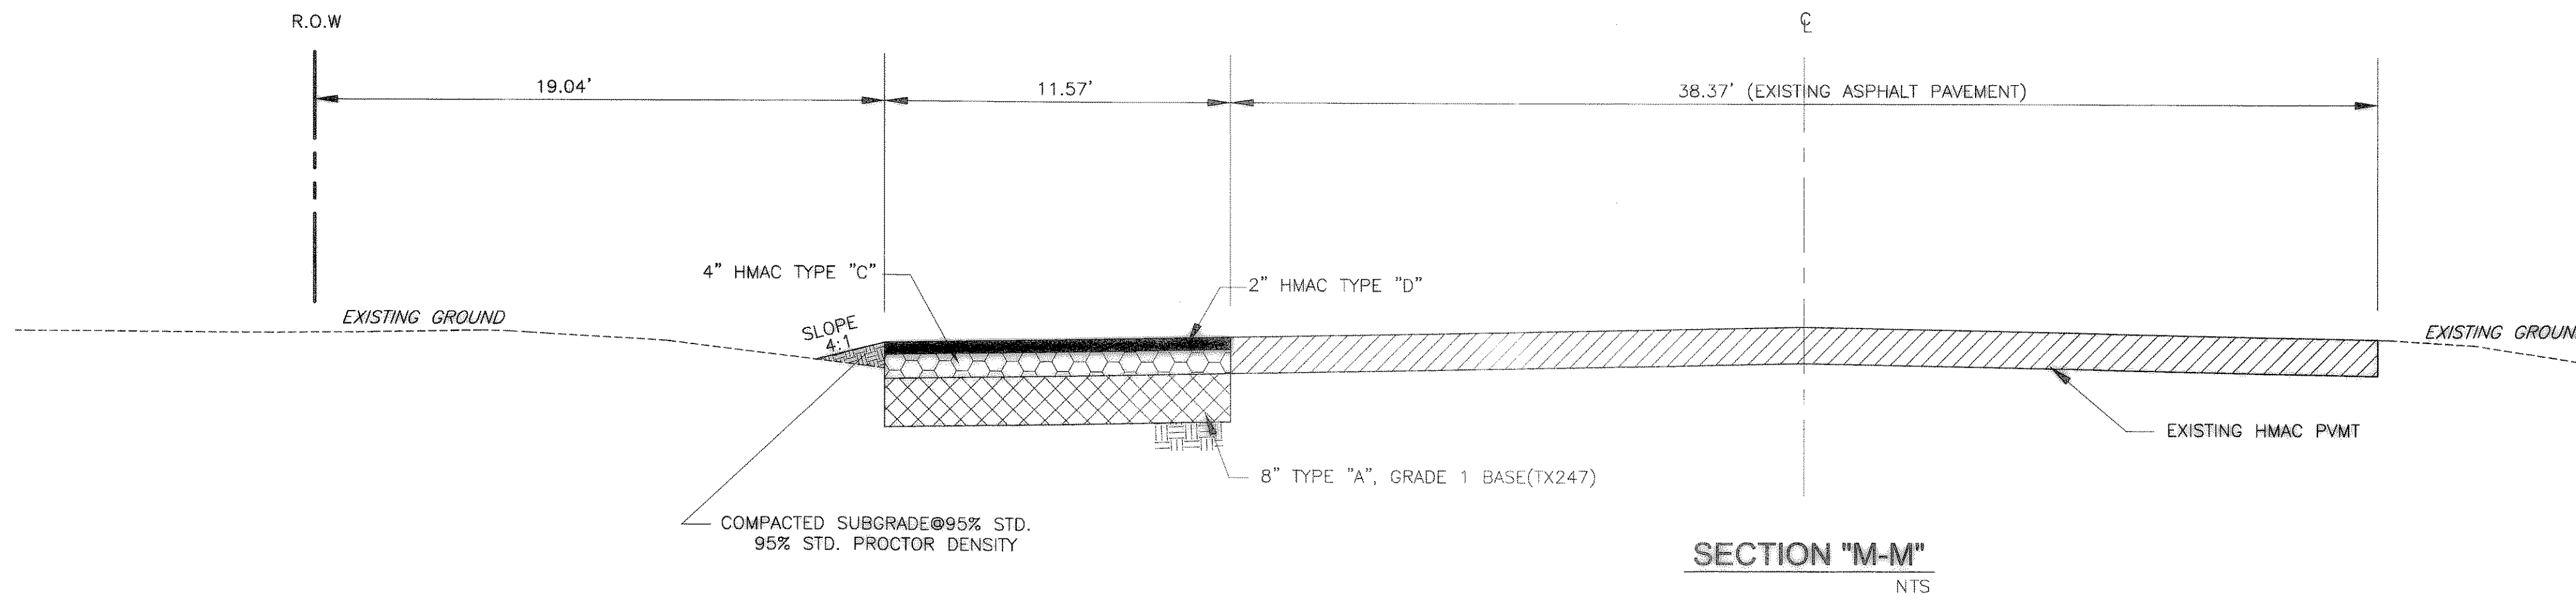

SECTION "M-M"
NTS

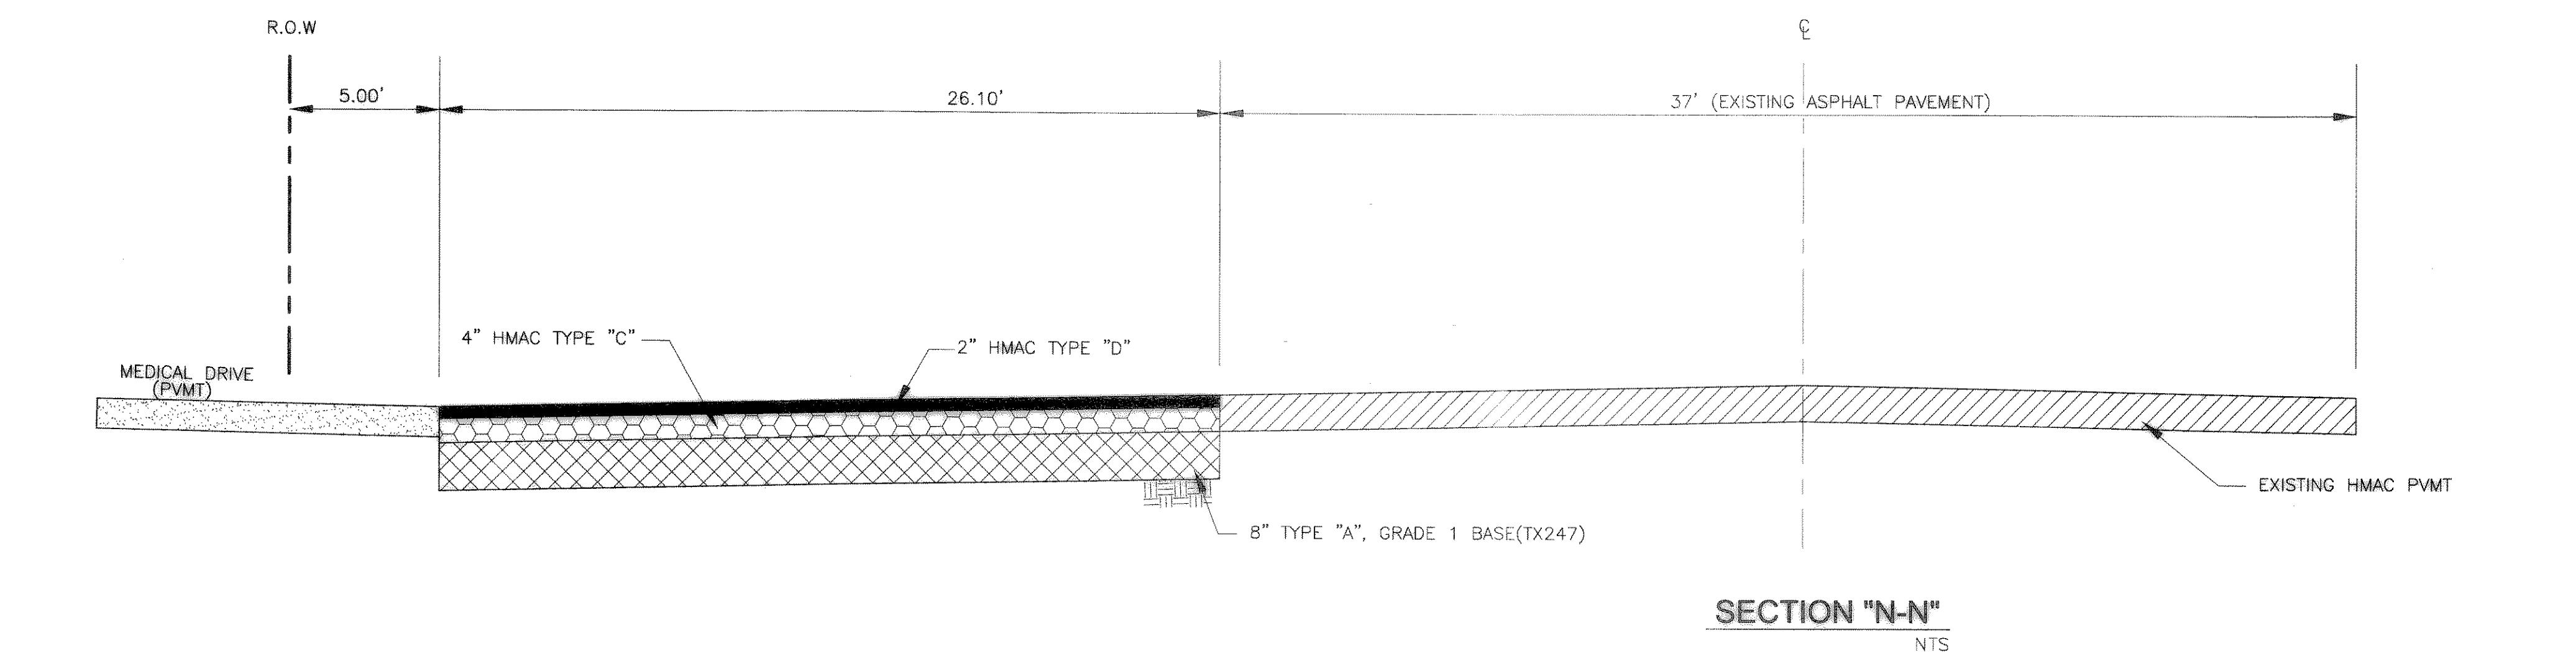

SECTION "N-N"
NTS

NOTE:
SEAL COAT ENTIRE WIDTH

AS BUILT
THIS IS TO CERTIFY THAT CHANGES AND
CORRECTIONS HAVE BEEN MADE TO
CONFORM TO THE CONTRACTOR'S
RECORD OF THIS PROJECT.



| | | | | | | |
|---|-------|----------|----------|-------|----------|------|
| CROSS SECTION DETAILS-4 | | | | | | |
| HORIZON RIDGE MEDICAL PARK | | | | | | |
| CITY OF ROCKWALL, TEXAS | | | | | | |
| PSA ENGINEERING | | | | | | |
| 17819 DAVENPORT ROAD, SUITE 215 DALLAS, TX 75252 (972) 248-9651 | | | | | | |
| DESIGN | DRAWN | DATE | SCALE | CHECK | FILE | NO. |
| PSA | PSA | 06/23/08 | AS SHOWN | PSS | 2616.HRM | C-24 |

Y:\2008\2616.HRM\AS-BUILT\SET 1\C-24-22-23-04.dwg

AS BUILT