


AS BUILT

THIS IS TO CERTIFY THAT CHANGES AND CORRECTIONS HAVE BEEN MADE TO CONFORM TO THE CONTRACTOR'S RECORD OF THIS PROJECT.

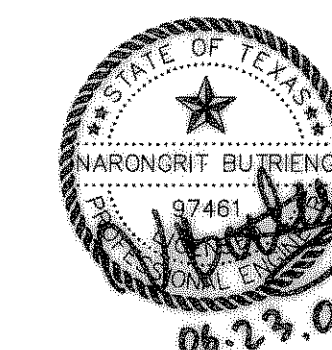

CROSS SECTION PLAN

HORIZON RIDGE MEDICAL PARK

CITY OF ROCKWALL, TEXAS

PSA ENGINEERING

17819 DAVENPORT ROAD, SUITE 215 DALLAS, TX 75252 (972) 248-9851

DESIGN	DRAWN	DATE	SCALE	CHECK	FILE	NO.
PSA	PSA	06/23/08	AS SHOWN	PSS	2616.HRM	C-20

AS BUILT