



LEGEND :

	PROPERTY LINE
	PROPOSED CONTOUR
	EXISTING CONTOUR
	INSTALL EARTH BERM
	PROP. RETAINING WALL (BY OTHER)

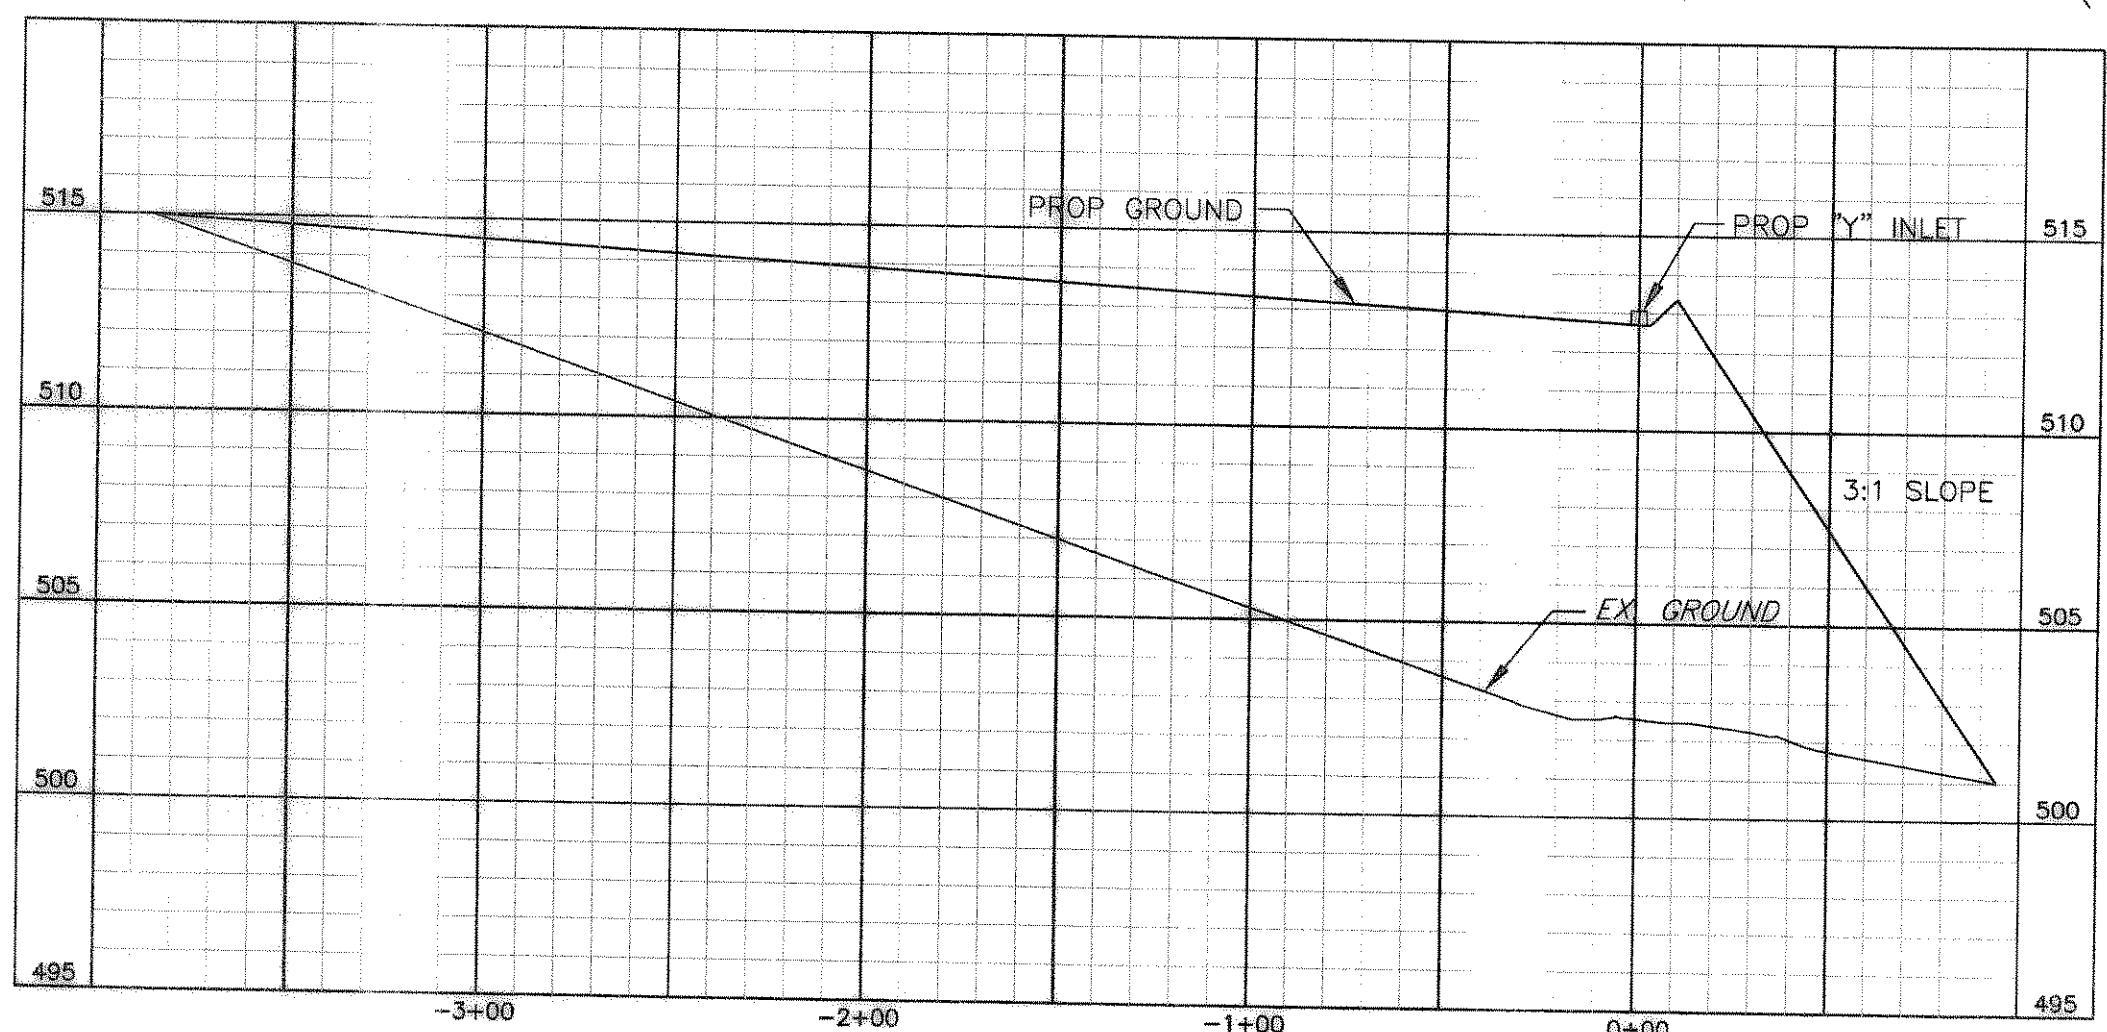

SECTION "A"

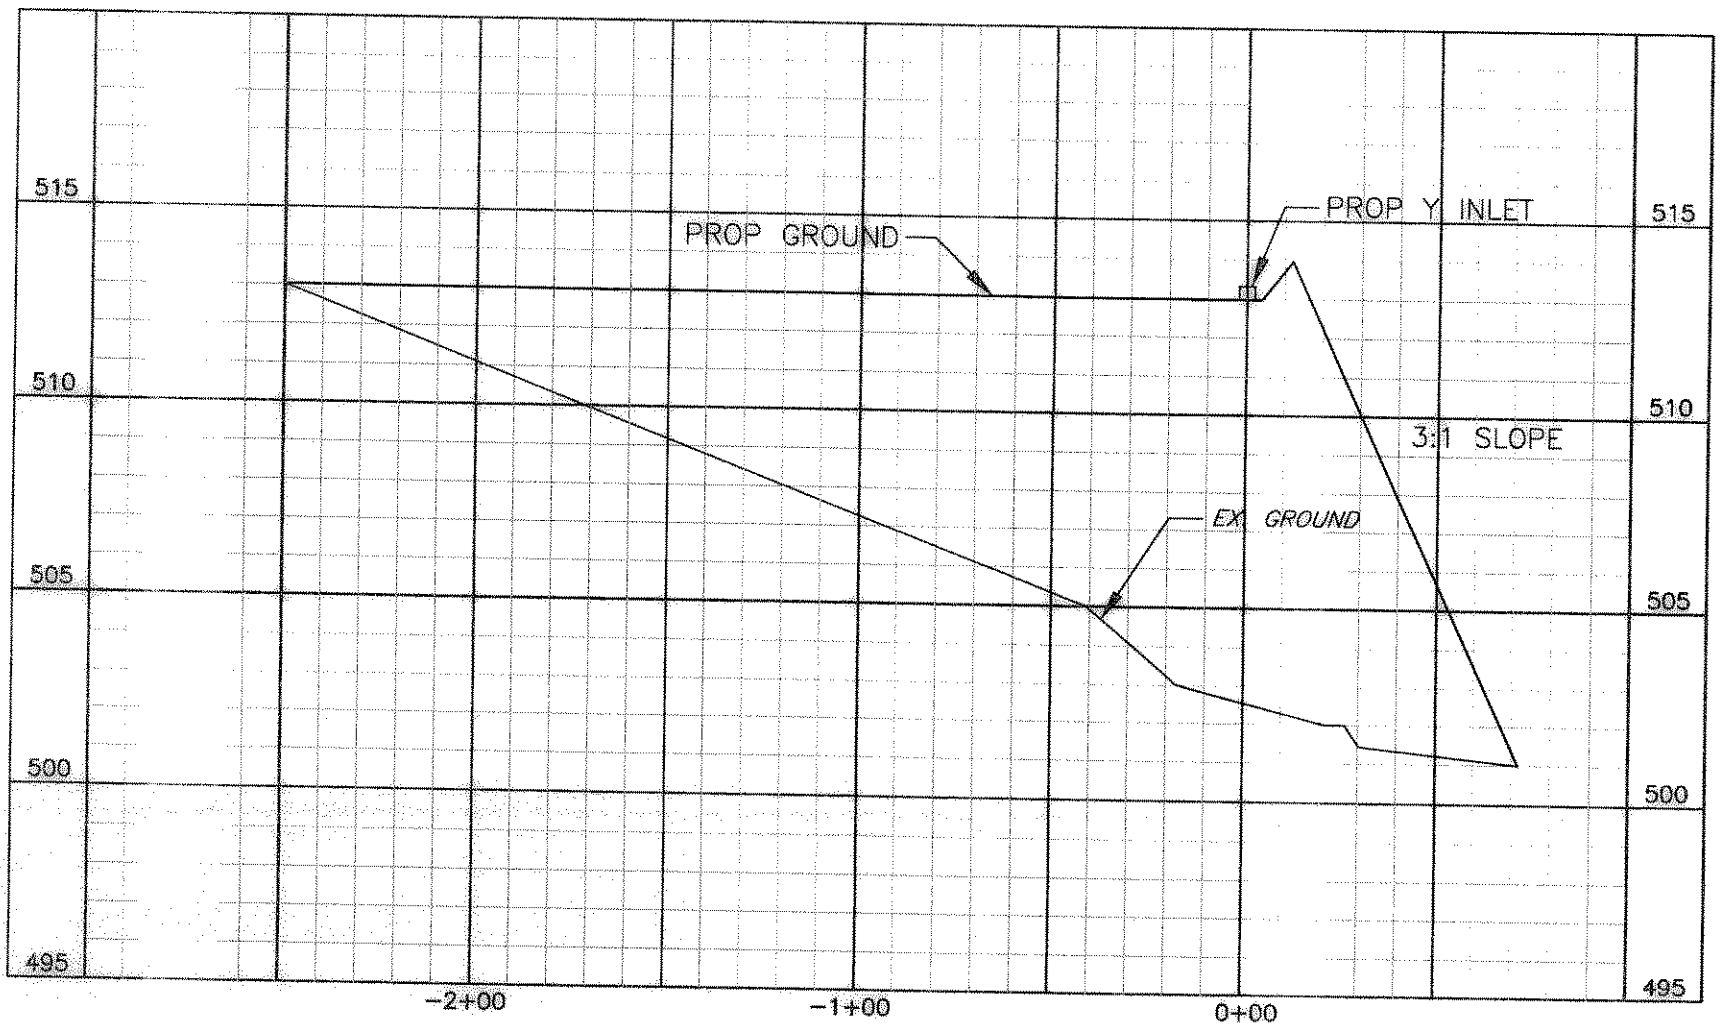

SECTION "B"

NOTE :

1. ALL WALL 4" AND OVER SHALL BE DESIGNED BY PROFESSIONAL ENGINEER (SIGNED AND SEALED PLAN) AND ENGINEER SHALL ACCEPT SAID WALL (IN LETTER FORM PROFESSIONAL ENGINEER SIGNED AND SEALED PRIOR TO ACCEPTANCE.
2. NO PART OF THE WALL (FOOTING, TIEBACK ETC) SHALL BE IN EASEMENTS RIGHT-OF-WAY AND/OR OFF-SITE.

TOW = TOP OF WALL
BOW = BOTTOM OF WALL

AS BUILT
THIS IS TO CERTIFY THAT CHANGES AND CORRECTIONS HAVE BEEN MADE TO CONFORM TO THE CONTRACTOR'S RECORD OF THIS PROJECT.



GRADING PLAN						
HORIZON RIDGE MEDICAL PARK						
CITY OF ROCKWALL, TEXAS						
PSA ENGINEERING						
17819 DAVENPORT ROAD, SUITE 215 DALLAS, TX 75252 (972) 249-9651						
DESIGN	DRAWN	DATE	SCALE	CHECK	FILE	NO.
PSA	PSA	06/23/08	AS SHOWN	PSS	2616.HRM	C-3

Y:\2006\2616.HRM\AS-BUILT\SET 1\C-3.dwg

AS BUILT