


**AS BUILT**

THIS IS TO CERTIFY THAT CHANGES AND CORRECTIONS HAVE BEEN MADE TO CONFORM TO THE CONTRACTOR'S RECORD OF THIS PROJECT.

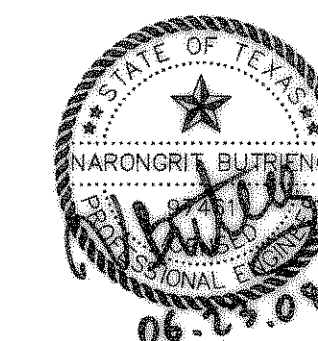

**LOCATION PLAN FOR  
HORIZON ROAD IMPROVEMENT**

**HORIZON RIDGE MEDICAL PARK**

**CITY OF ROCKWALL, TEXAS**

**PSA ENGINEERING**

17819 DAVENPORT ROAD, SUITE 215 DALLAS, TX 75252 (972) 248-9661

DESIGN	DRAWN	DATE	SCALE	CHECK	FILE	NO.
PSA	PSA	06/23/08	AS SHOWN	PSS	2616.HRM	C-16

AS BUILT