


**BENCH MARK**  
 ▲ IRON ROD FOUND IN THE R.O.W. OF HORIZON ROAD AND NORTHEAST CORNER OF HORIZON RIDGE MEDICAL PARK ADDITION  
 ELEVATION (m.s.l.) 499.06

**AS BUILT**  
 THIS IS TO CERTIFY THAT CHANGES AND CORRECTIONS HAVE BEEN MADE TO CONFORM TO THE CONTRACTOR'S RECORD OF THIS PROJECT.

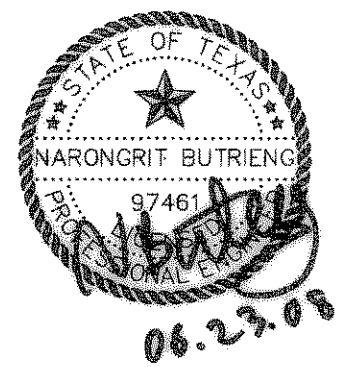

<b>MEDICAL DRIVE PLAN AND PROFILE</b> STA. 0+00 TO 8+50						
HORIZON RIDGE MEDICAL PARK						
CITY OF ROCKWALL, TEXAS						
PSA ENGINEERING 17819 DAVENPORT ROAD, SUITE 215 DALLAS, TX 75252 (972) 248-9651						
DESIGN	DRAWN	DATE	SCALE	CHECK	FILE	NO.
PSA	PSA	06/23/08	AS SHOWN	PSS	2616.HRM	C-5

Y:\2006\2616.HRM\AS-BUILT\SET 1\C-5-6.dwg

AS BUILT