


NOTE:
NO SERVICE ON LINES DEEPER THAN 10'



AS BUILT
THIS IS TO VERIFY THAT CHANGES AND CORRECTIONS HAVE BEEN MADE TO CONFORM TO THE CONTRACTOR'S RECORD OF THIS PROJECT.

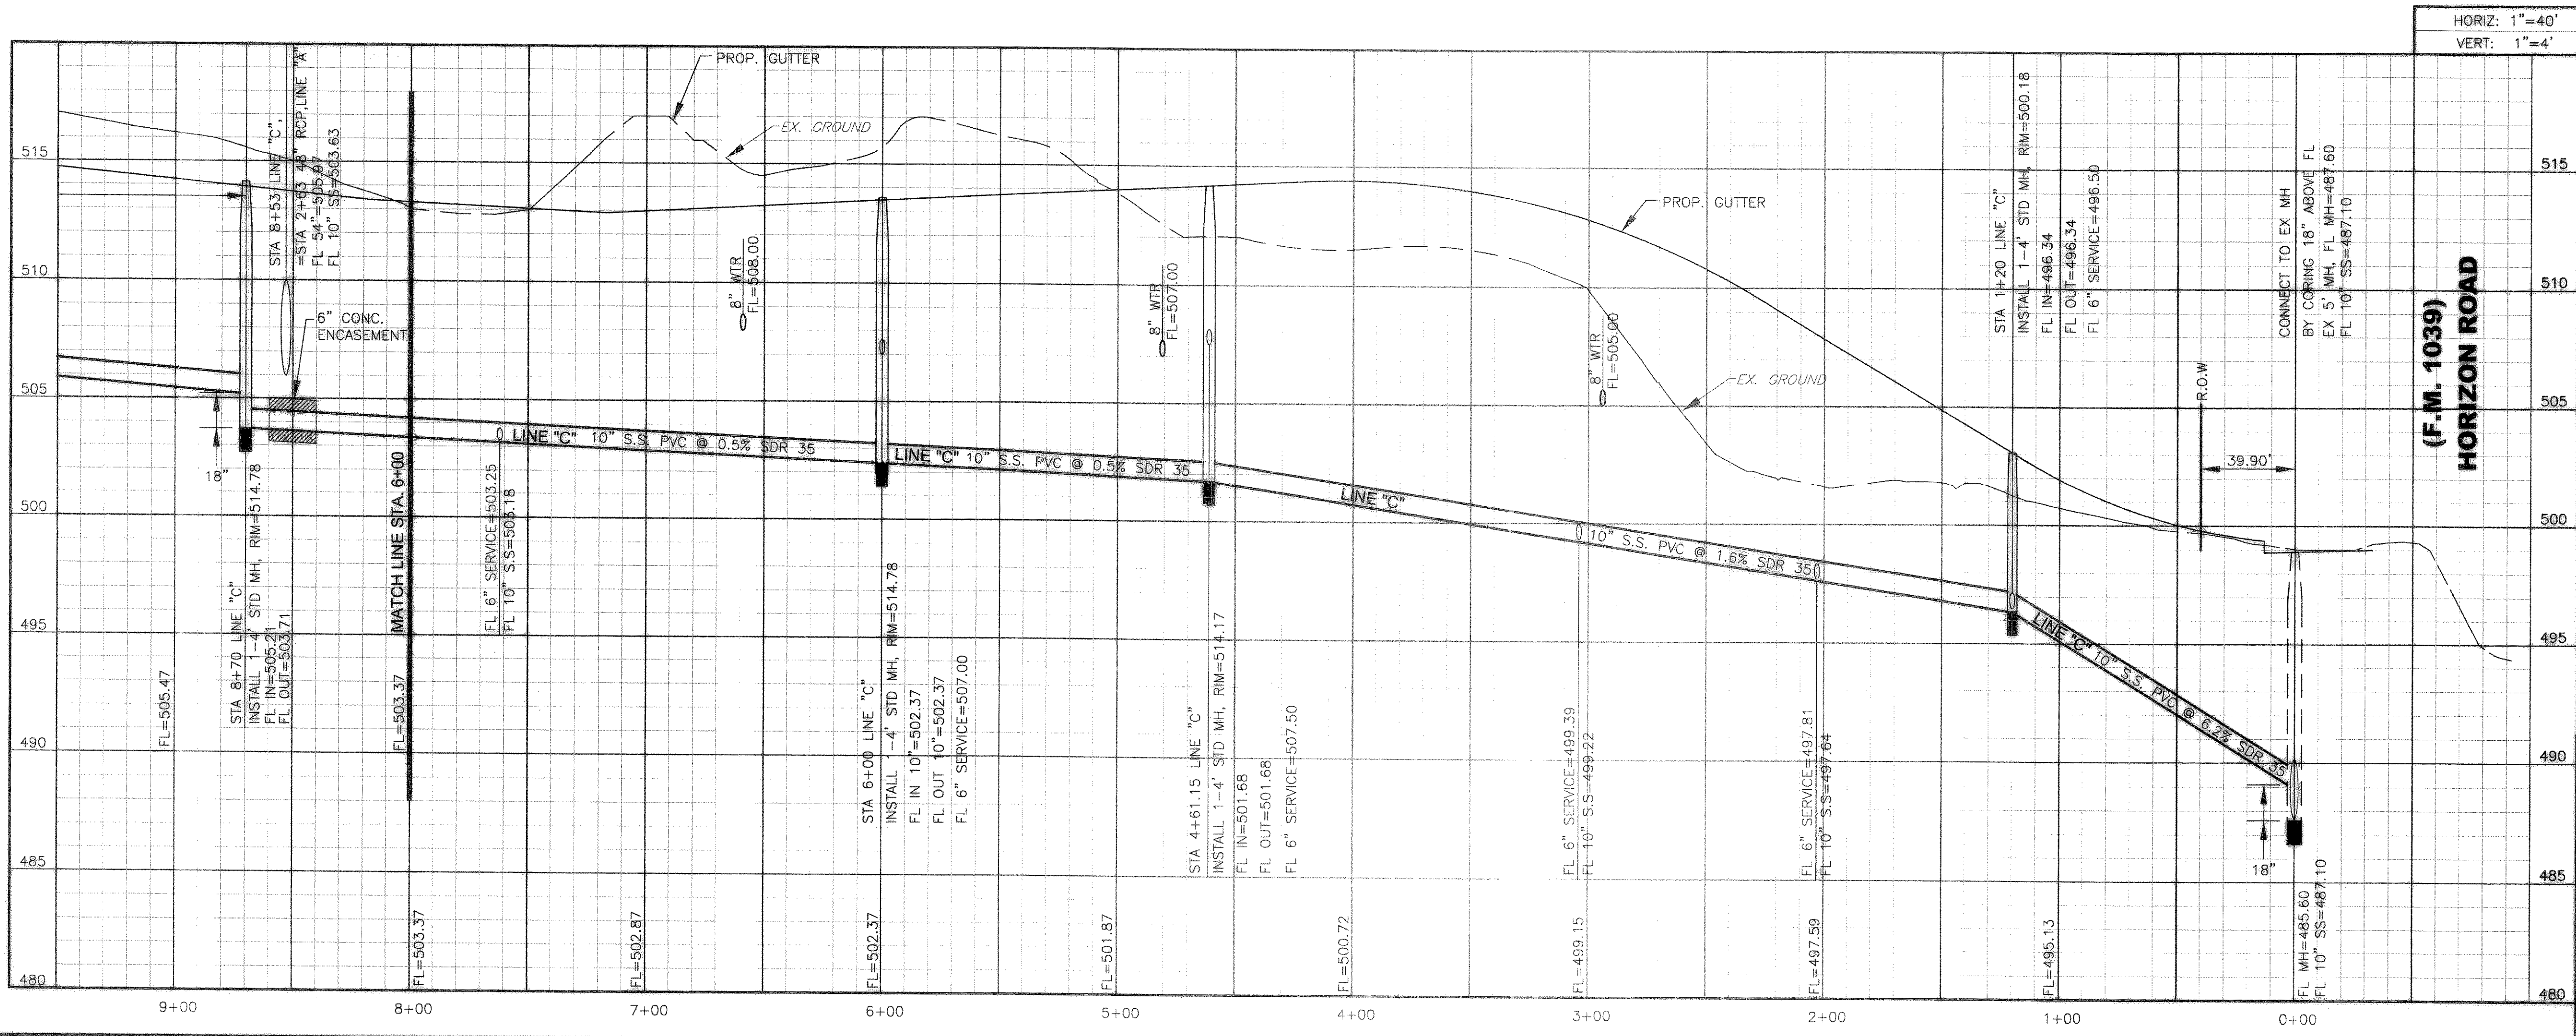

PLAN AND PROFILE SANITARY SEWER LINE "C" STA. 0+00 TO 8+00						
HORIZON RIDGE MEDICAL PARK						
CITY OF ROCKWALL, TEXAS						
PSA ENGINEERING 17819 DAVENPORT ROAD, SUITE 215 DALLAS, TX 75252 (972) 248-9651						
DESIGN	DRAWN	DATE	SCALE	CHECK	FILE	NO.
PSA	PSA	06/23/08	AS SHOWN	PSS	2616.HRM	C-14

AS BUILT

Y:\3006\3616.HRM\AS-BUILT\SET 1\C-14.dwg