


**NOTE**  
 ALL DOMESTIC AND IRRIGATION LINES TO HAVE  
 DOUBLE CHECK VALVES AND BACKFLOW PREVENTERS

LOCATE EXIST 2" WTR SERVICE  
 & CONNECT NEW LINE TO  
 EXISTING SERVICE

EX. WTR NOT TO BE  
 INTERRUPTED UNTIL  
 NEW LINE IS CONNECT

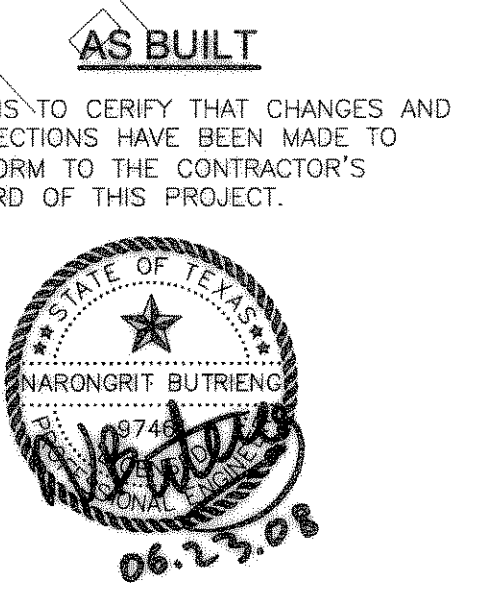

WATER LAYOUT PLAN						
HORIZON RIDGE MEDICAL PARK						
CITY OF ROCKWALL, TEXAS						
PSA ENGINEERING						
17819 DAVENPORT ROAD, SUITE 215 DALLAS, TX 75262 (972) 248-9651						
DESIGN	DRAWN	DATE	SCALE	CHECK	FILE	NO.
PSA	PSA	06/23/08	AS SHOWN	PSS	2616.HRM	C-11

1:\2006\2616.HRM\AS-BUILT\SET 1\C-11.dwg

AS BUILT