


CIVIL ENGINEERING CONSTRUCTION PLANS
ROCKWALL OFFICE PARK – PHASE 2
LOTS 10R1, 10R2 & 10R3, BLOCK A
HORIZON RIDGE ADDITION
AN ADDITION TO THE CITY OF ROCKWALL
ROCKWALL COUNTY, TEXAS

INDEX OF DRAWINGS

- Cover Sheet
- Re-Plat
- C1 Drainage Area Map
- C2 Grading & Drainage Plan
- C3 Water & Sanitary Sewer Plan
- C4 Utility Profiles
- C5 Paving Plan
- C6 Erosion Control Plan
- C7 Miscellaneous Details

NOTE: ALL WORK ON CIVIL PLANS INCLUDING GRASSING SHALL BE INSTALLED PRIOR TO P-5 (BUILDING) APPROVAL.

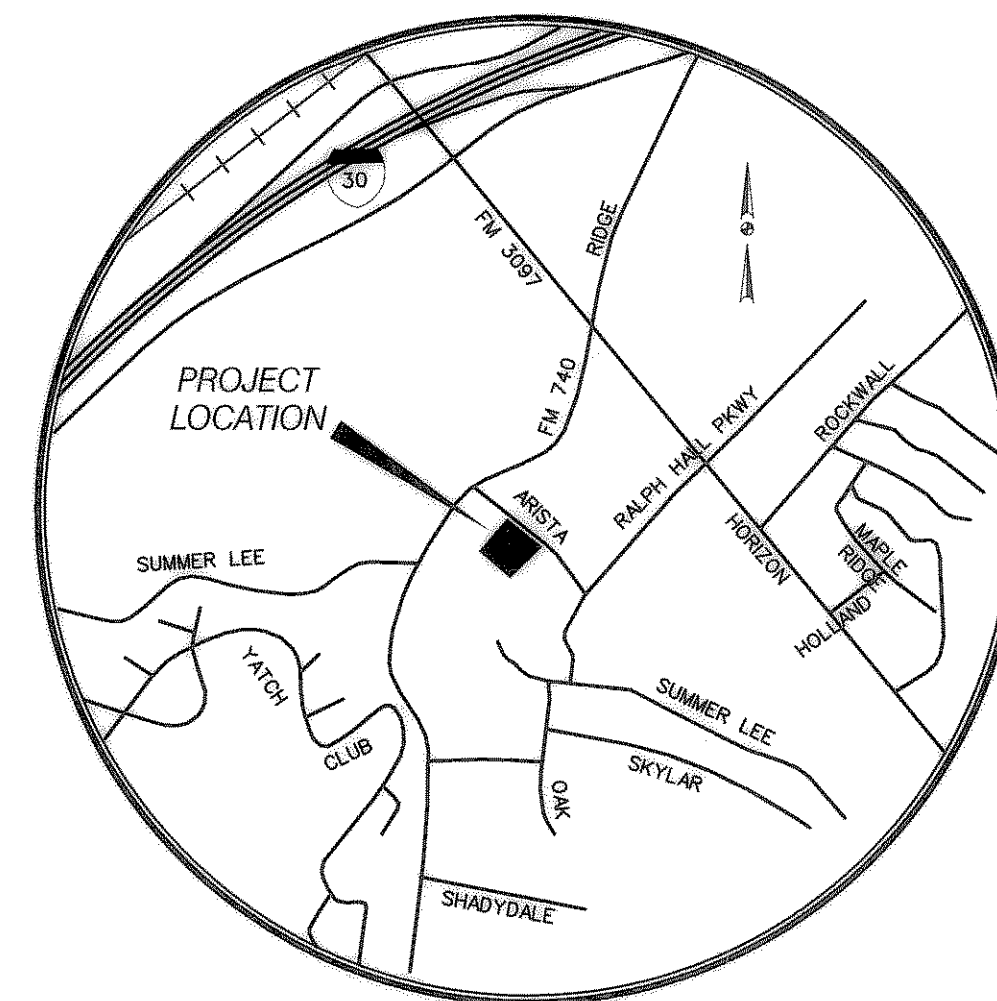


VICINITY MAP
(DALLAS MAPSCO 30-C-K)
NOT TO SCALE

OWNER/DEVELOPER
MR. TIM THOMPSON, ASSOCIATE
REALTY CAPITAL ROCKWALL, LTD.
99 MAIN STREET, SUITE 200
COLLEYVILLE, TEXAS 76034
TEL. (817) 488-4200 X 123

ARCHITECT
CNK ASSOCIATES, INC.
2045 N. HIGHWAY 360, SUITE 160
GRAND PRAIRIE, TEXAS 75050
TEL. (817) 640-0100
FAX. (817) 633-3309

CIVIL ENGINEER/SURVEYOR
LIM & ASSOCIATES, inc.
engineering & surveying consultants
1701 N. Market Street, Suite 405 / LB20
Dallas, Texas 75202
Tel. (214) 698-1888 • Fax (214) 698-9881

MAY 2006

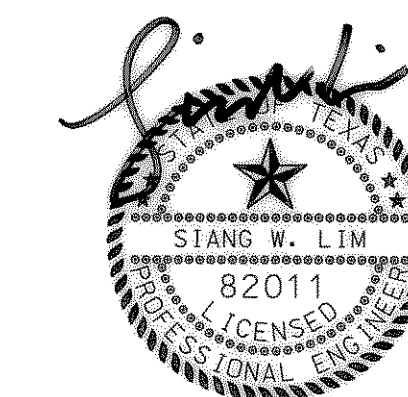

THE SEAL APPEARING ON THIS DRAWING WAS AUTHORIZED BY SIANG W. LIM, P.E. ON MAY 8, 2007

AS-BUILT

NOTE: THESE PLANS HAVE BEEN REVISED TO CONFORM WITH CONSTRUCTION RECORDS PROVIDED BY THE CONTRACTOR. ENGINEER DID NOT CERTIFY TO FIELD VERIFYING ANY CHANGES MADE DURING CONSTRUCTION.

ROCKWALL OFFICE PARK – PHASE 2 (LOTS 10R1, 10R2, & 10R3, BLOCK A, HORIZON RIDGE ADDITION)