


SITework PLANS FOR

SOUTHTRUST BANK

LOT 7R, BLOCK A HORIZON RIDGE ADDITION ROCKWALL, TEXAS

SHEET INDEX

C-1A & B	PLAT
C-2	SITE PLAN
C-3	DIMENSION CONTROL PLAN
C-4	PAVING PLAN
C-5	GRADING PLAN
C-6	DRAINAGE AREA MAP
C-7	DRAINAGE PLAN
C-8	STORM SEWER PROFILES
C-9	WATER & SANITARY SEWER PLAN
C-10	EROSION CONTROL PLAN
L-101	LANDSCAPE PLAN
L-102	LANDSCAPE SPECIFICATIONS AND DETAILS
L-201	IRRIGATION PLAN
L-202	IRRIGATION SPECIFICATIONS AND DETAILS

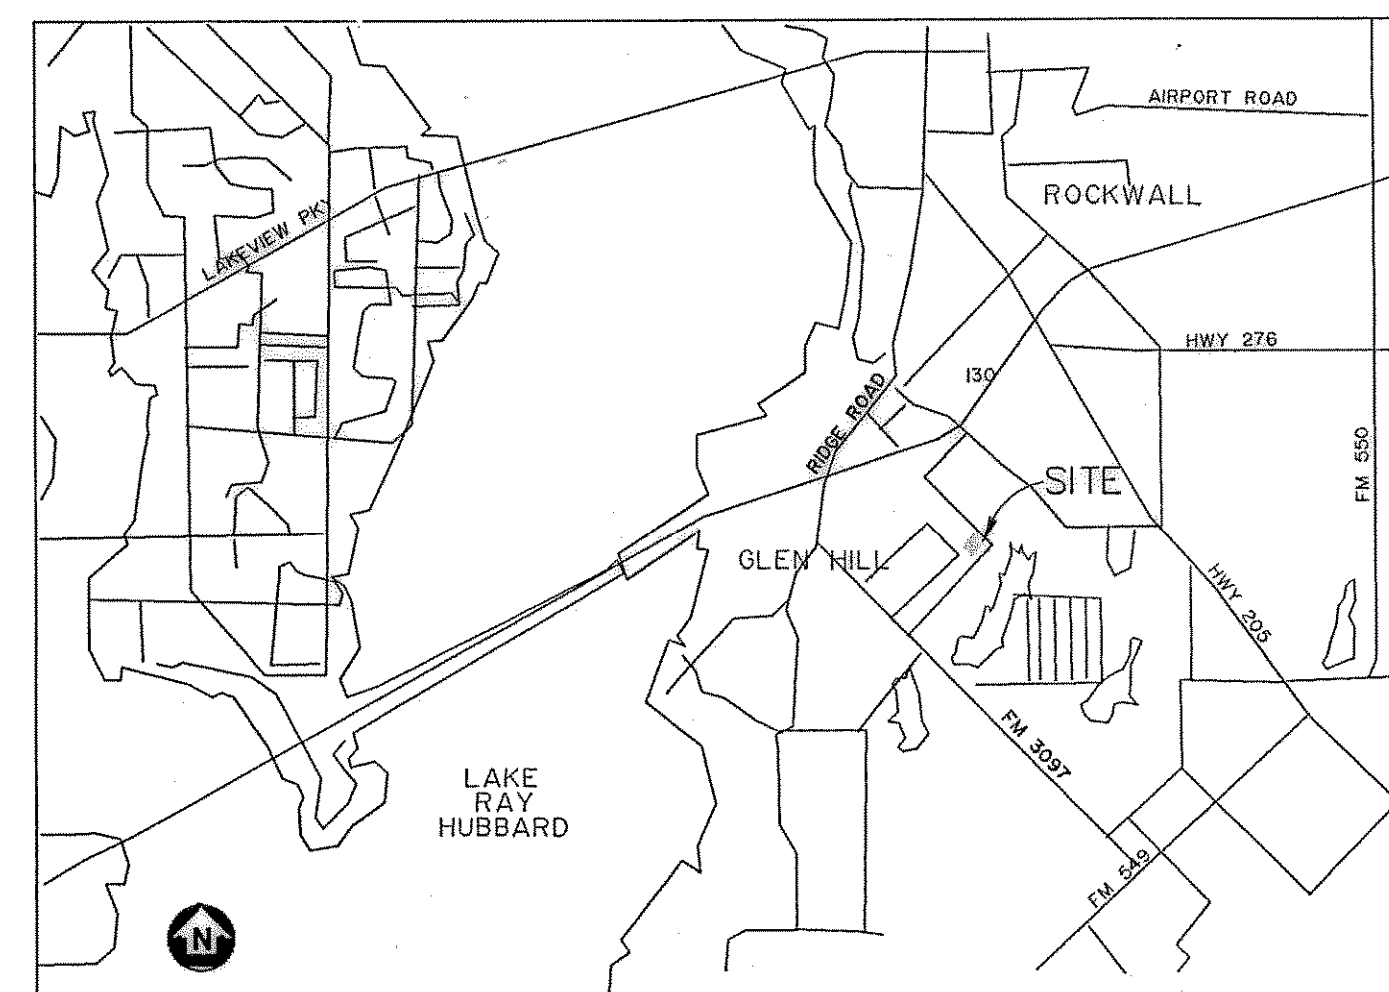

VICINITY MAP
NOT TO SCALE

OWNER:
SOUTHTRUST BANK
500 OFFICE PARK DRIVE, SUITE 300
BIRMINGHAM, AL 35223
CONTACT: JON KRAL
(205) 667-6274
FAX: (205) 667-6270

PROJECT ARCHITECT:
TGS ARCHITECTURE
5323 SPRING VALLEY ROAD, SUITE 200
DALLAS, TEXAS 75254
CONTACT: STEVE CAMPBELL
(972) 788-1945
FAX: (972) 788-2309

AS BUILT
DATE 03-03-04

CIVIL ENGINEER:
LAWRENCE A. CATES & ASSOCIATES, INC.
14200 MIDWAY ROAD, SUITE 122
DALLAS, TEXAS 75244
CONTACT: BRYAN M. BURGER, P.E.
(972) 385-2272
FAX: (972) 980-1627