



AS BUILT
DATE 03-03-04

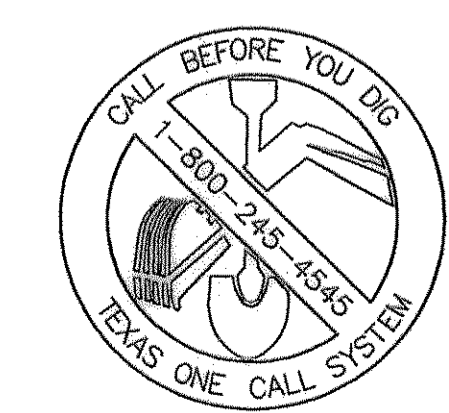

THE SEAL APPEARING ON THIS DOCUMENT WAS AUTHORIZED BY BRYAN M. BURGER, P.E. 90880 ON 03/20/03

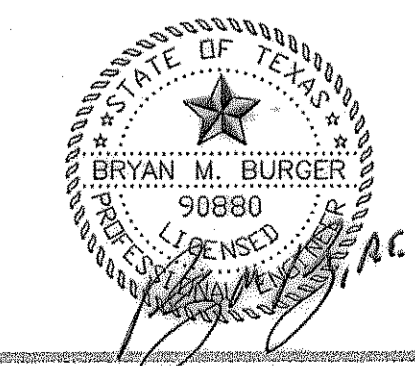

REV.	DATE	REMARKS				
STORM SEWER PROFILES						
LOT 7R, BLOCK A HORIZON RIDGE ADDITION THE CITY OF ROCKWALL, TEXAS						
LAWRENCE A. CATES & ASSOC., INC. 14200 MIDWAY ROAD, SUITE 122 (972) 385-2272		CONSULTING ENGINEERS DALLAS, TEXAS				
DESIGN	DRAWN	DATE	SCALE	NOTES	FILE	NO.
BMB	MCL	02-19-03	1"=40' 1"=6'	D.P.	23012 STORM1	C-8