


CONSTRUCTION PLANS
 WASHINGTON MUTUAL
 ARISTA ROAD & RIDGE ROAD (F.M. 740)
 CITY OF ROCKWALL, TEXAS
 FOR
 HORIZON RIDGE ADDITION
 BLOCK A, LOT NO. 11R
 1.1354 ACRES ZONED PD-9

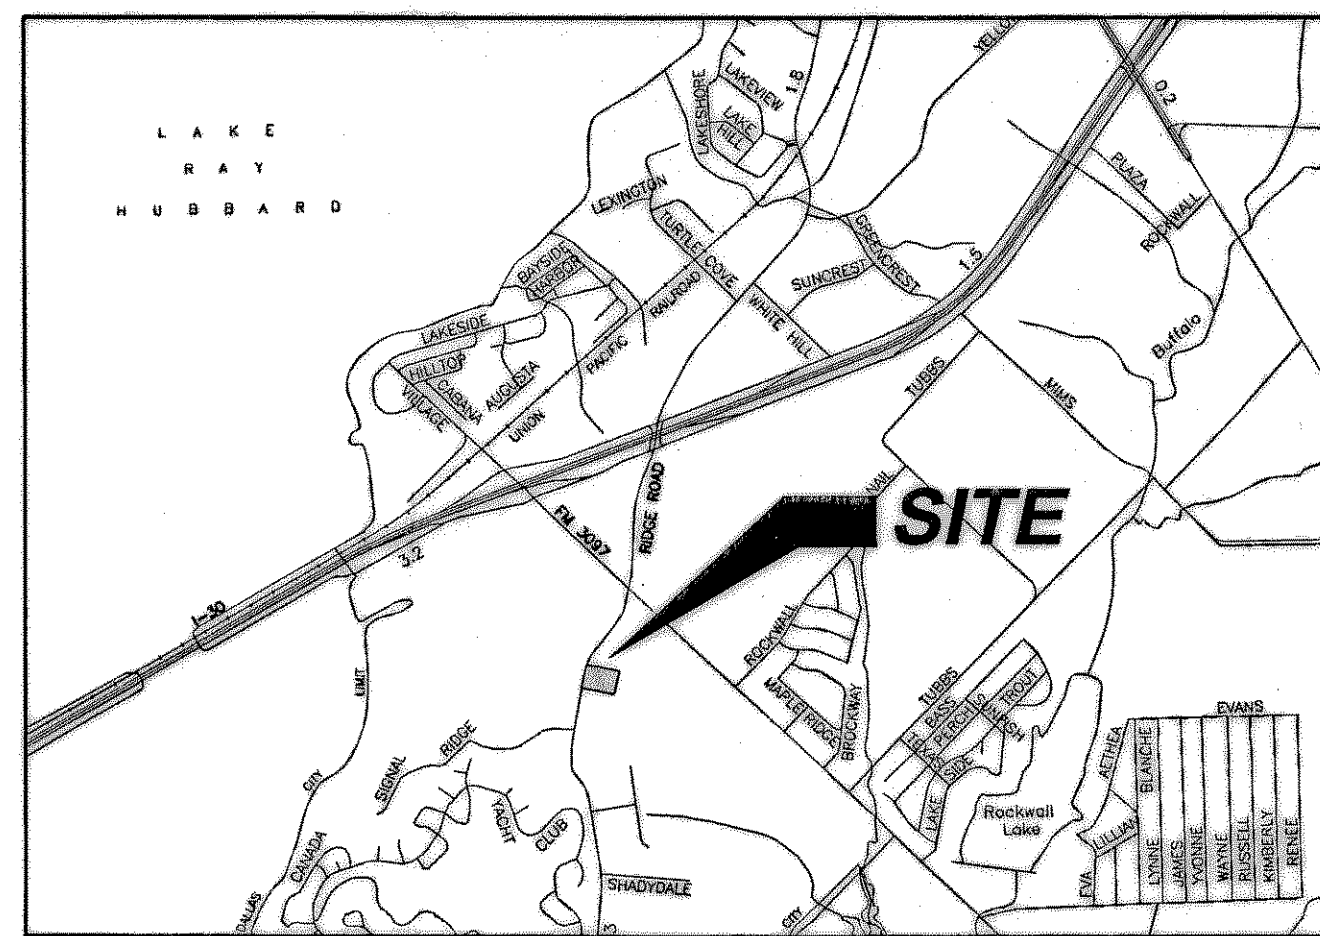

N.T.S.

CITY OF ROCKWALL, TEXAS

SHEET INDEX

NO.	TITLE
N/A	COVER SHEET
SP1	SITE PLAN
C1	GENERAL NOTES AND LEGEND
C2	DIMENSION CONTROL PLAN
C3	DRAINAGE AREA MAP & CALCULATIONS
C4	GRADING, DRAINAGE, & UTILITY PLAN
C5	STORM SEWER PROFILES
C10	RETAINING WALL DETAILS
LP-1	LANDSCAPE PLAN

OWNER:

YANCEY-HAUSMAN DEVELOPMENT
 13333 NORTHWEST FRWY, SUITE 150
 HOUSTON, TEXAS 77040
 PH: (713) 462-8802
 FAX: (713) 895-8214
 CONTACT: MARK SEPULVEDA

PATE ENGINEERS

8150 BROOKRIVER DRIVE
 SUITE S-700
 DALLAS, TEXAS, 75247
 TEL (214) 357-2981
 FAX (214) 357-2985


JOB NO. 001702600

CONTACT: EARL A. ESCOBAR, P.E.

RECORD DRAWING

REVISED TO REFLECT KNOWN CHANGES MADE DURING CONSTRUCTION.

DATE 04 DEC 03

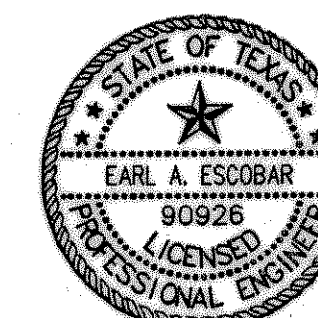

DECEMBER 4, 2003
 JOB NO. 001702600