



No.	Date	Description
-----	------	-------------

WASHINGTON
MUTUAL

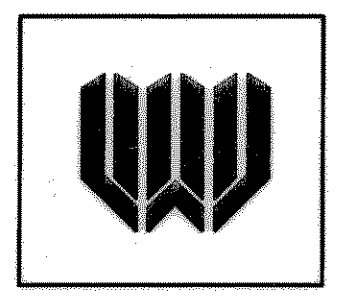


ROCKWALL, TEXAS

Yancey-Hausman Development

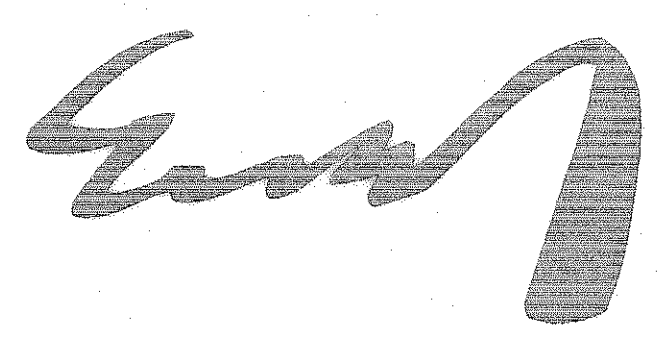

Philip Ewald Architecture Incorporated
Architecture Interior Design Planning
4000 Yorklum Blvd Suite 100 Houston Texas 77006
Tel: 713.922.9777 Fax: 713.922.2107

RECORD DRAWING
REVISED TO REFLECT KNOWN CHANGES MADE DURING CONSTRUCTION.
Earl A. Escobar DATE 04/02/03

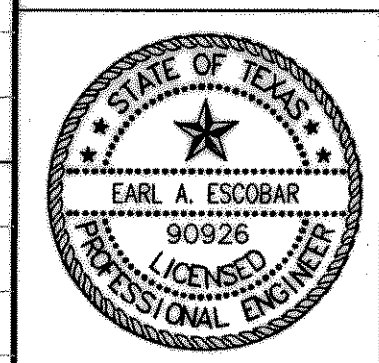

Drawn: MTL
Checked: J.M.
Proj No: 001702600
Date: 12-04-03
Scale: H: 1'-30'
V: 1'-3'

REF. SHEET C1 FOR
GENERAL NOTES

PATE ENGINEERS

8150 BROOKRIVER DRIVE
SUITE S-700
DALLAS, TEXAS 75247
PH. (214) 357-2981
FAX (214) 357-2985

STORM SEWER
PROFILES

C5

NO.	DATE	DESCRIPTION
-----	------	-------------

JOB NO. 001702600

X:\Projects\Yancey-Hausman\Rockwall\DWG\WATER\WSD1.dwg, 12/04/03 09:56:18 PM, Earle