


# OFF-SITE IMPROVEMENT PLANS FOR LOT 5, BLOCK A HORIZON RIDGE ADDITION THE CITY OF ROCKWALL, TEXAS

## SHEET INDEX

C-1	FINAL PLAT
C-1A	FINAL PLAT
C-2	FINAL PLAT
C-3	FINAL PLAT
C-4	DIMENSION CONTROL PLAN
C-5	PAVING PLAN
C-6	GRADING PLAN
C-6A	DRAINAGE AREA MAP
C-6B	DRAINAGE AREA MAP
C-7	DRAINAGE PLAN
C-8	STORM SEWER PROFILES
C-9	WATER & SANITARY SEWER PLAN
C-10	SANITARY SEWER PROFILE
C-11	EROSION CONTROL PLAN
C-12	HEADWALL DETAILS

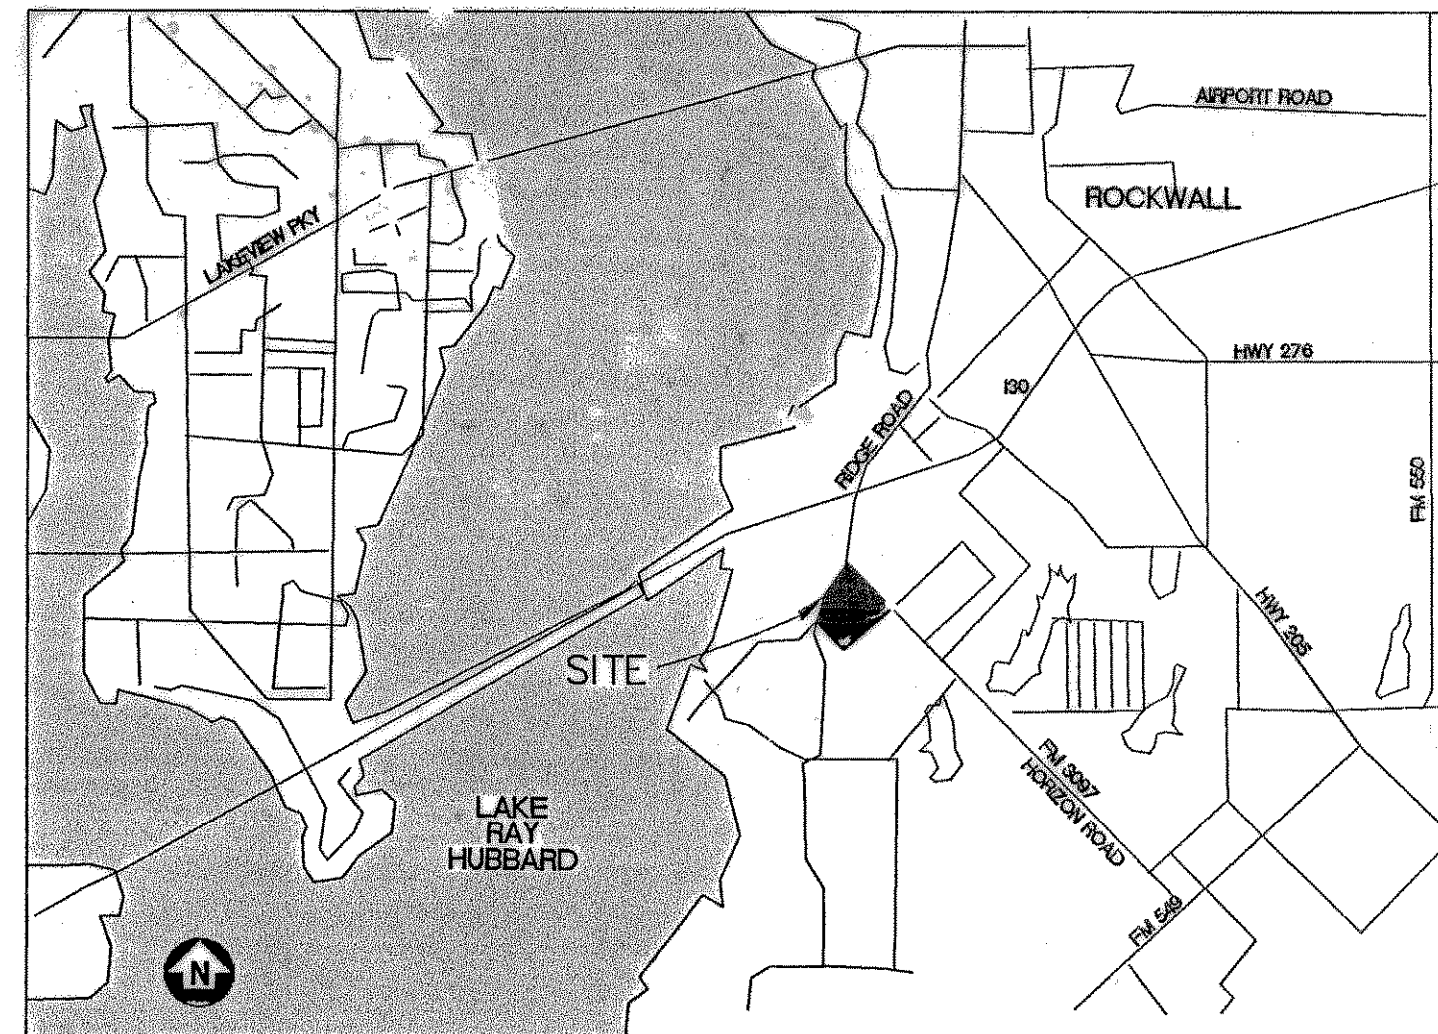

VICINITY MAP  
N.T.S.

DEVELOPER/OWNER:  
REGENCY CENTERS CORPORATION  
8140 WALNUT HILL LANE  
DALLAS, TEXAS 75231  
CONTACT: KEITH SMITH  
(214) 706-2500  
FAX: (214) 696-9512

ENGINEER:  
LAWRENCE A. CATES & ASSOCIATES, INC.  
14200 MIDWAY ROAD, SUITE 122  
DALLAS, TEXAS 75244  
CONTACT: BRYAN M. BURGER, P.E.  
(972) 385-2272  
FAX: (972) 980-1627



AS BUILT  
DATE 11-6-03